IREDELL COUNTY HEALTH DEPARTMENT - *ENVIRONMENTAL HEALTH* ☑ STATESVILLE OFFICE 704-878-5305 ☐ MOORESVILLE OFFICE 704-664-5281

IMPROVEMENT PERMIT / AUTHORIZATION TO CONSTRUCT / OPERATION PERMIT / EXISTING SYSTEM INSPECTION

PERMIT # 17582J PIN # 4756864897 DATE 11-9-12

OWNER Debra Turner APPLICANT: Moore's Environmental PHONE: Home/Cell # 704-873-9928 Business # 704-902-1122

SITE ADDRESS 176 Country Dr. OWNER / APPLICANT ADDRESS 1227 Troutman Dr.

SITE DIRECTIONS Hwy 21 N TR Jane Sowers Rd TL Country Dr.

SUBDIVISION N/A BLOCK / SECTION N/A LOT # N/A LOT AREA 5.15 acres DESIGN FLOW 360 gpd L.T.A.R. 0.3

Septic Tank Existing Gallons: STB Date

Pump Tank Gallons: P T Date

Pump Make Model Serial #

No. Nitrification Fields: 1 No. Lines 3 Linear Feet 300

Trench Width 36" Max. Trench Bottom Depth 36" Gravel Depth N/A

☐ New System ☑ Repair ☐ Expansion System Type I II ☒ III IV V VI

System Description:

Repair System Description: 25% Reduction

Maintenance Agreement Required ☐ YES ☑ NO

☑ GRAVITY ☐ PRESSURE

☑ Residence No. Bedrooms 3

☐ Business No. Persons

☐ Other No. Employees


☐ Slab ☑ Crawl Space

☐ Basement w/plumbing ☐ Basement w/o plumbing


Water Supply: ☑ Private ☐ Public ☐ Community

Comments / Conditions: Install 300' of 25% Reduction system on contour with serial distribution. Connect new lines to existing lines as shown below. Replace septic tank, septic tank tee, and/or distribution box if needed

INITIAL SITE SKETCH

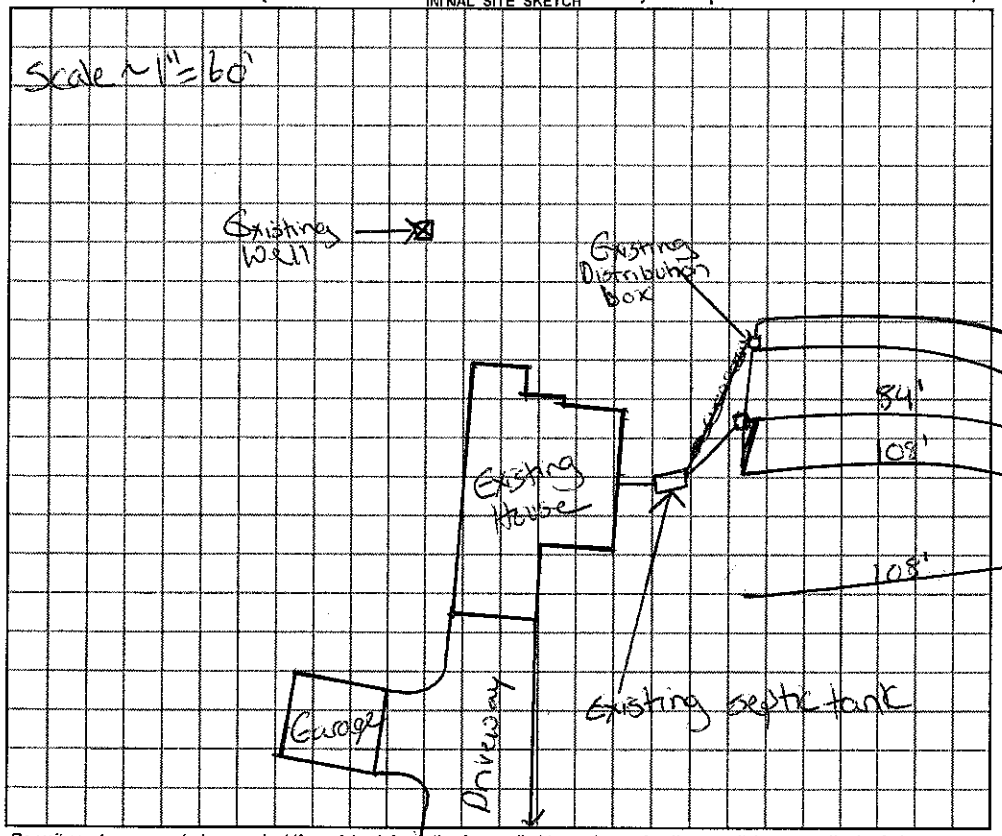

AS BUILT SKETCH

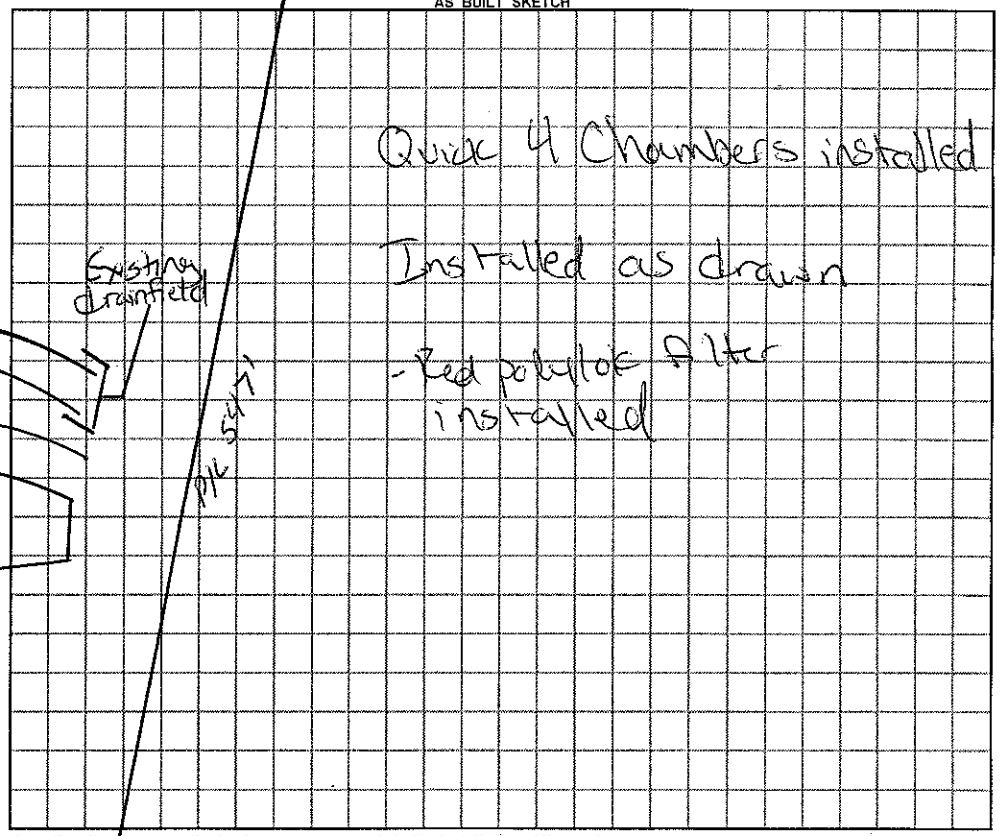

Permit can be suspended or revoked if any false information is supplied toward securing the permit / any unauthorized changes are made to the site / any unauthorized changes are made in the installation of the system.

☐ ***IMPROVEMENT PERMIT*** *with plat valid without expiration.* ☑ ***IMPROVEMENT PERMIT*** *with plat ~~valid without expiration~~ site plan valid 60 mo.* ☑ ***AUTHORIZATION TO CONSTRUCT*** valid for period equal to IMPROVEMENT PERMIT--not to exceed 60 mo.

Owner / Applicant Signature: Juliana C. Moore Date 11-9-12 Installed by: A1 Backhoe

IMPROVEMENT PERMIT by: Justin Henderson REHS Date 11-9-12 OPERATION PERMIT by: Justin Henderson REHS Date 11-28-12

AUTHORIZATION TO CONSTRUCT by: Justin Henderson REHS Date 11-9-12 Existing System Inspected by: REHS Date

YOU SHOULD CONTACT A LOCATOR SERVICE PRIOR TO ANY EXCAVATION

White Copy – Environmental Health YELLOW COPY (Final) Owner / Applicant PINK COPY (Initial) Owner / Applicant