03581

IREDELL COUNTY HEALTH DEPARTMENT

(SEPTIC TANK) IMPROVEMENTS PERMIT AND CERTIFICATE OF COMPLETION
(Ground Absorption Sewage Disposal System – G. S. Chapter 130-Article 13C)

OWNER OR CONTRACTOR Dr. Fred Marks DATE 1-3-86 PERMIT NO. _____

PHONE: Business _____ Home _____

LOCATION Baysmount meadows lot 8 In Front of Ben Daniels Home S. R. No. _____

SUBDIVISION NAME _____ LOT NO. _____ SECTION OR BLOCK NO. _____

House (✓) Mobile Home ( ) Business ( ) Other _____


No. Bedrooms 4 No. Bathrooms 2 1/2

Garbage Disposal Unit Yes (✓) No ( )
Auto. Dishwasher Yes (✓) No ( )
Auto. Wash. Machine Yes (✓) No ( )
Site Suitable Yes (✓) No ( )

Character & Porosity of Soil Clayey
Percolation Rate 24
Topography 2 to 6 Eo
Depth to Water Table 10'+
Rock or other impervious formations None

Lot Area 4.05 acres

_____ Basement with Plumbing _____ Basement without Plumbing ✓ No Basement

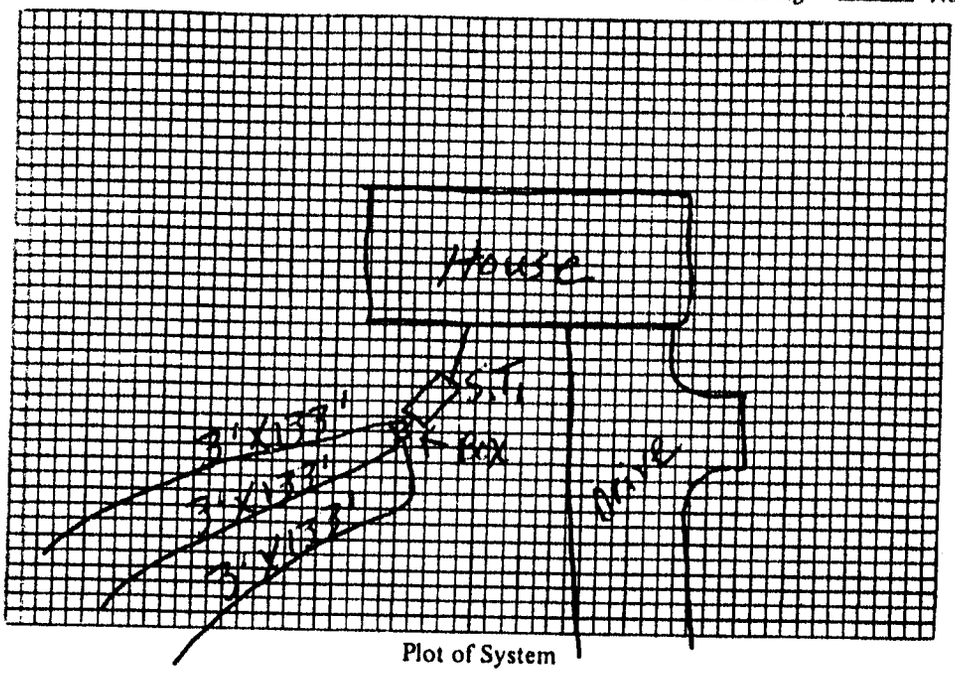

Plot of System

Size of Tank 1500 Gals.
Nitrification Field:
No. of Lines 3
Sq. Ft. 1200 Linear Ft. 400
Depth of Stone in Lines _____
Water Supply: Individual ( )
Public ( )

Installed by James Hartness

I understand and agree to install septic tank system as specified on this Improvements Permit.

Signed: _____

IMPROVEMENTS PERMIT BY P. C. Moore

COMMENTS: _____

CERTIFICATE OF COMPLETION BY P. C. Moore DATE 1-3-86

EXISTING SYSTEM CHECKED BY: _____ DATE _____

CONSTRUCTION MUST COMPLY WITH ALL OTHER APPLICABLE STATE AND LOCAL REGULATIONS.

Permit is VOID if any unauthorized changes are made in installation of system and/or if any false information is supplied in making Improvements Permit.

Health Dept. Copy: White Inspection Dept. Copy: Yellow Sanitarian's Copy: Pink Owner's Copy: Gold