IREDELL COUNTY HEALTH DEPARTMENT

STATESVILLE 704-878-5305 MOORESVILLE 704-664-5281

IMPROVEMENT PERMIT / AUTHORIZATION TO CONSTRUCT / OPERATION PERMIT / EXISTING SYSTEM INSPECTION

PERMIT# 14736 PIN# 4758879678 DATE 1-22-08

OWNER OR APPLICANT Rick Wilson Custom Homes PHONE: Business 704-902-3343 Home 704-538-0701

ADDRESS 1438 Jackson Lane Statesville NC 28625

LOCATION 21N (R) Jane Sowers (L) Country Drive 1st on Right before Applegate-SHC

SUBDIVISION Baymont Meadows BLOCK / SECTION ____ LOT 1 LOT AREA 1.11 SITE CLASS. B DESIGN FLOW 480 L.T.A.R. 3

Septic Tank: 1000 Gallons: STB 750 Date 1-24-08

Pump Tank: ____ Gallons: PT ____ Date ____

Pump Make: ____ Model ____ Serial No. ____

Nitrification Field: No Fields ____ Square Feet 1000 Linear Feet 400

No Lines 4 Trench Width 3'11" Max Trench Bottom Depth 31" Gravel Depth 11" ☑ Gravity ☐ Pressure

☑ New System ☐ Repair ☐ Expansion System Type: I II (III) IV V VI

System Description: 3 Bdrm Conv

Repair System Description: 500 lin Ft.

Maintenance Agreement Required: ☐ Yes ☑ No

☐ House/Mod. Home No. Bedrooms 4

☐ Mobile Home No. Persons ____

☐ Business No. Employees ____


☐ Other ____

Water Supply: ☐ Individual ☑ Public ☐ Community

☐ Slab ☑ Crawl Space ☐ Basement w/plumbing ☐ Basement wo/plumbing

Comments:/Conditions: End Cap & Distribution Box 32 + Out

INITIAL SITE SKETCH

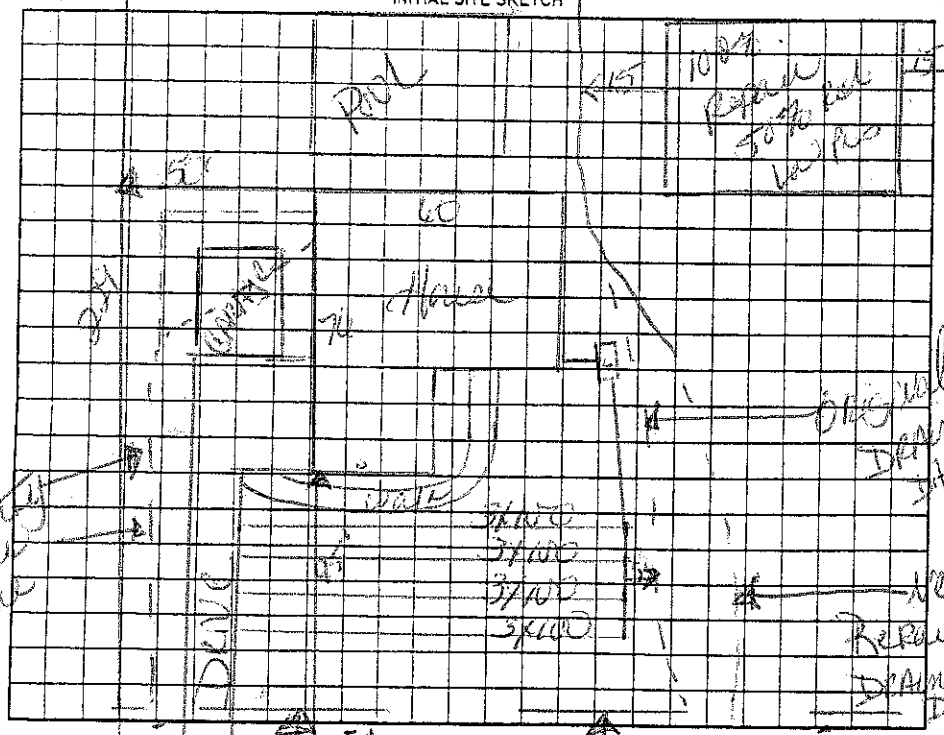

Comments:/Conditions: Filter Original Drainage pipe is Removed - Soil must be placed into cut and septic must maintain at least 5' off of adjacent drive.

(1) Septic over 1 to 1½ feet must be removed to create less than 3:1 Slope

(2) Mulched and Pasture Maintain all setbacks

(3) Maintain 100' feet from well

(4) Upon until Drainage Ditch is removed and Septic area taken down to Level Slope.

(5) Check with Home owners Association for Permit to allow Septic

AS BUILT SKETCH

Permit can be suspended or revoked if any false information is supplied toward securing the permit/any unauthorized changes are made to the site/any unauthorized changes are made in the installation of the system. Improvement Permit with plat valid without expiration ☐ Improvement Permit with site plan valid for sixty months ☑ Authorization to Construct is valid for a period equal to that of Improvement Permit - not to exceed sixty months.

Signed: [signature] REAUTHORIZATION 180 date 1-22-08 Installed by: [signature] date 4-1

Improvement Permit by: Ricky Cook date 1-22-08 Operation Permit by: [signature] date 12-30-08

Authorization to Construct by: Ricky Cook date 5-21-08 Existing System Inspection by: ____ date ____

HEALTH DEPT. COPY: WHITE OWNER COPY (FINAL): YELLOW OWNER COPY (INITIAL): PINK