# IREDELL COUNTY HEALTH DEPARTMENT

STATESVILLE 704-878-5305 MOORESVILLE 704-664-5281

## IMPROVEMENT PERMIT / CERTIFICATE OF COMPLETION / OPERATION PERMIT / EXISTING SYSTEM INSPECTION

PROPERTY DESCRIPTION NO. ~~92012~~ 058040 DATE 9-7-95 TAX MAP NO 11E-A-78 Watershed: ☐ Yes ☐ No

OWNER OR CONTRACTOR Scott Geiler PHONE: Business Home 871-8905

ADDRESS 196 Seed House Road Statesville

LOCATION 64E TL Old Mocksville Rd TR Seed House Rd 1/2 mi RT

SUBDIVISION BLOCK / SECTION LOT LOT AREA 15 acres SITE CLASS. PS DESIGN FLOW 360 L.T.A.R. .3

Septic Tank: 1000 Gallons; STB Date 4-7-97
Pump Tank: Gallons; PT Date
Pump Make: Model Serial No.
Nitrification Field: No Fields 1 Square Feet 400 Linear Feet 400
No Lines 3 Trench Width 36 Max Trench Bottom Depth 36

☑ New System ☐ Repair System Type: I, II, III, IV, V, VI
System Description: Conv. Gravity
Repair System Description: " "
Maintenance Agreement Required: ☐ Yes ☑ No
Gravel Depth 12" ☐ Slab ☐ Crawl Space ☑ Basement w/plumbing ☐ Basement wo/plumbing

☑ House/Mod. Home No. Bedrooms 3
☐ Mobile Home No. Bathrooms 3.5
☐ Business No. Employees
☐ Other


Water Supply:
☐ Individual
☐ Community
☑ Public

Comments:


Seed to rise pr

Comments:

INITIAL SITE SKETCH

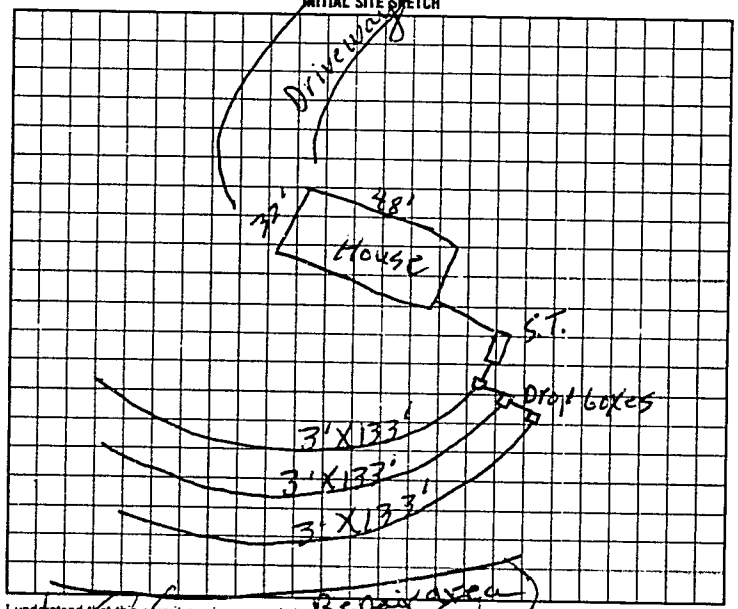


AS BUILT SKETCH

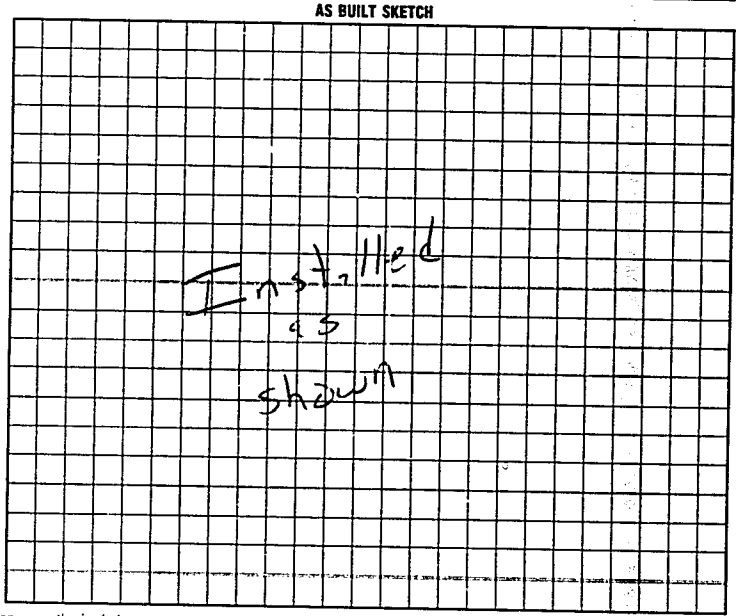


I understand that this permit can be suspended or revoked if any false information is supplied toward securing the permit/any unauthorized changes are made to the site/any unauthorized changes are made in the installation of the system.

Signed Charles A. Fox Jr. Revised

Improvement Permit by: F. C. Moore date 9-7-95

Existing System Inspection by date

Installed by: David Yount

Certificate of Completion by: date

Operation Permit by Mark C. Oaks RS date 6-5-97

HEALTH DEPT COPY: WHITE INSPECTION COPY (FINAL): GREEN OWNER COPY (FINAL): YELLOW INSPECTION COPY (INITIAL): PINK OWNER COPY (INITIAL): GOLD

0 L 9 0 0 0