IREDELL COUNTY HEALTH DEPARTMENT

STATESVILLE 704-878-5305 MOORESVILLE 704-664-5281

IMPROVEMENT PERMIT / CERTIFICATE OF COMPLETION / OPERATION PERMIT / EXISTING SYSTEM INSPECTION

PROPERTY DESCRIPTION NO. 23612 DATE 5-4-96 TAX MAP NO. 11E-A-65A Watershed: ☐ Yes ☑ No

OWNER OR CONTRACTOR JOHN D. HOGTON PHONE: Business _____ Home 873-1434

ADDRESS 539 BEECHWOOD FARM ROAD, STATESVILLE NC 28677

LOCATION OLD MOCKSVILLE ROAD, TR SEED HOUSE ROAD, DN LEFT 0.4 MILE.

SUBDIVISION _____ BLOCK / SECTION _____ LOT _____ LOT AREA 1.18 ACRE SITE CLASS. PS DESIGN FLOW 360 L.T.A.R. 0.30 GPD/FT²

Septic Tank: 1000 Gallons; STB 1012 Date 3-8-96

Pump Tank: _____ Gallons; PT _____ Date _____

Pump Make: _____ Model _____ Serial No. _____

Nitrification Field: No Fields 1 Square Feet 1200 Linear Feet 400

No Lines 4 Trench Width 36" Max Trench Bottom Depth 18-36 Gravel Depth 12"

☑ New System ☐ Repair System Type: I (II) III. IV. V. VI

System Description: CONVENTIONAL GRAVITY

Repair System Description: CONVENTIONAL GRAVITY

Maintenance Agreement Required: ☐ Yes ☑ No

☐ House/Mod. Home No. Bedrooms 3

☑ Mobile Home No. Bathrooms 2

☐ Business No. Employees _____

☐ Other FUTURE 3BR HOUSE


☐ Slab ☐ Crawl Space ☐ Basement w/plumbing ☐ Basement wo/plumbing

Water Supply:
☐ Individual
☐ Community
☑ Public


Comments:

Comments:

INITIAL SITE SKETCH

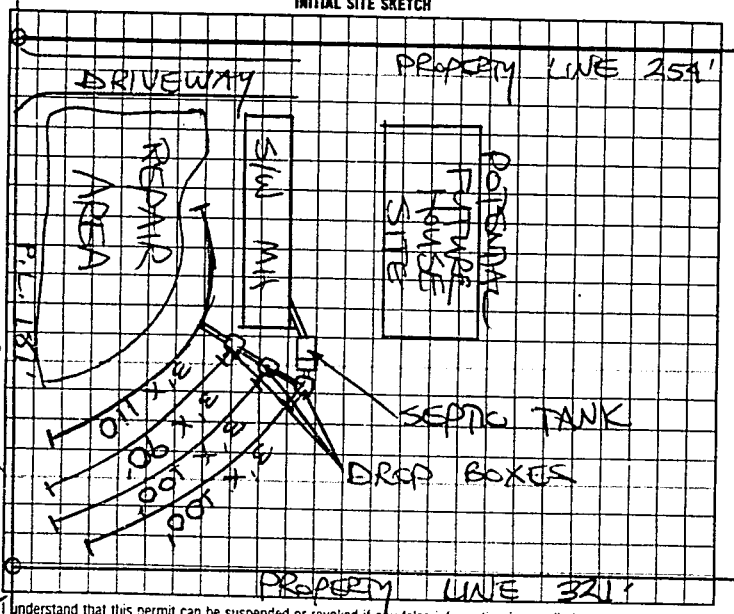

AS BUILT SKETCH

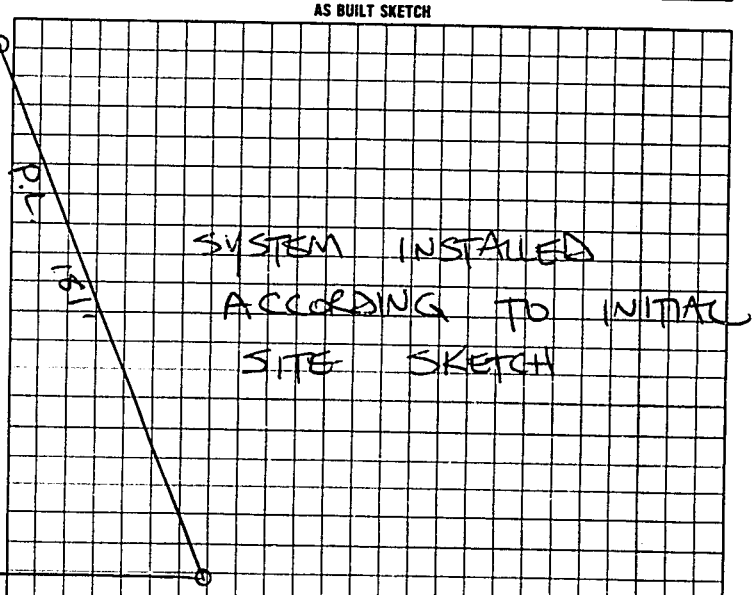

I understand that this permit can be suspended or revoked if any false information is supplied toward securing the permit/any unauthorized changes are made to the site/any unauthorized changes are made in the installation of the system.

Authorization to Construct is valid five (5) years from date of issuance. Improvement Permit has no expiration date.

Signed: X Joe D Hogton

Improvement Permit by: STEVE HODRICK date 5-4-96

Existing System Inspection by: STEVE HODRICK date 5-4-96

AUTHORIZATION TO CONSTRUCT: (APPLICANT COPY WHITE) (INSPECTION COPY PINK) (OWNER COPY YELLOW)

Installed by: JOHN HOLTON, ET-AL-

Certificate of Completion by: _____ date _____

Operation Permit by STEVE HODRICK date 5-13-96

(INSPECTION COPY PINK) (OWNER COPY GOLD)