IREDELL COUNTY HEALTH DEPARTMENT

CI

STATESVILLE 704-878-5305 MOORESVILLE 704-664-5281

IMPROVEMENT PERMIT / AUTHORIZATION TO CONSTRUCT / OPERATION PERMIT / EXISTING SYSTEM INSPECTION

PERMIT# 102741 PIN# 4756-97-2187.1 DATE 9-17-01

OWNER OR CONTRACTOR EDWIN HUNTER HOMES PHONE: Business 704-873-0568 Home

ADDRESS 1602 DANIE AVE STATESVILLE, NC 28677

LOCATION HWY 21 N, (R) JANE SOWERS (L) COUNTRY DRIVE, ON RT PAST CURVE

SUBDIVISION BAYMOUNT BLOCK / SECTION LOT LOT AREA 4.34 AC SITE CLASS PS DESIGN FLOW 360 L.T.A.R. .25

Septic Tank: 1000 Gallons; STB 1012 Date 04.14.02

Pump Tank: [redacted] Gallons; PT Date

Pump Make: Model Serial No.

Nitrification Field: No Fields 1 Square Feet [redacted] 1440 Linear Feet 480'

No Lines 5 Trench Width 36" Max Trench Bottom Depth 36" Gravel Depth 12"

X New System ☐ Repair System Type: I (II) III. IV. V. VI

System Description: CONV GRAV / GEOMAT PUMP

Repair System Description: PUMP CONV

Maintenance Agreement Required: ☐ Yes X No

X House/Mod. Home No. Bedrooms 3

☐ Mobile Home No. Bathrooms 2

☐ Business No. Employees

☐ Other


☐ Slab ☐ Crawl Space X Basement w/plumbing ☐ Basement wo/plumbing

Water Supply: ☐ Individual X Public ☐ Community

Comments/Conditions: (1) START LINES 15' OFF SMALL WASHOUT (2) MAINTAIN SETBACKS (3) BASEMENT PLUMBING NEEDS GRINDER PUMP & SETTLING TANK (1) (4) FLOOR LEVEL & UPSTAIRS GRAVITY INTO SEPTIC TANK (2) (5) CONNECT

Comments/Conditions: SETTLING TANK SO WHEN FULL, WILL GRAVITY INTO SEPTIC TANK (6) KEEP H_2O LINE 10' FROM ANY PART OF SYSTEM (7) USE FILTERS IN BOTH TANKS (8) USE 2 SEPTIC TANKS BECAUSE OF THE NEEDED BAFFLE WALL

INITIAL SITE SKETCH NOT TO SCALE

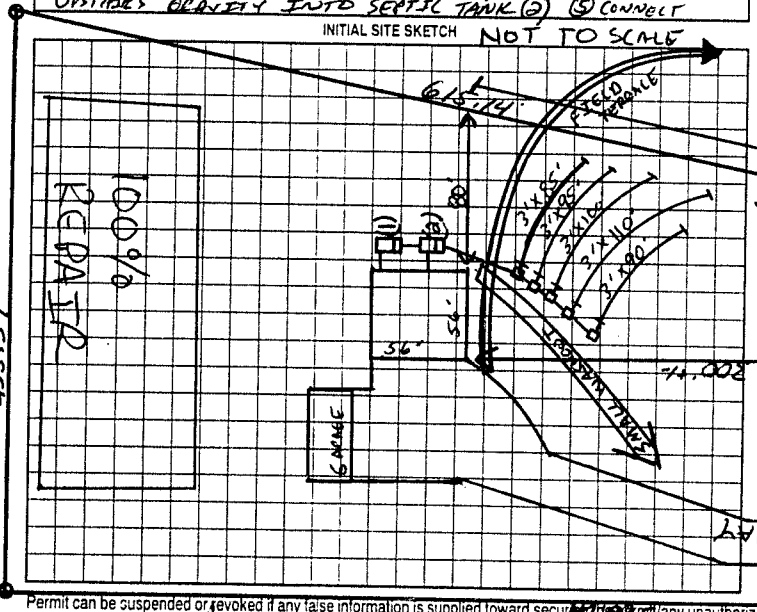


AS BUILT SKETCH

(8) BASEMENT IS NOT TO DAYLIGHT

POLYLOK FILTERS & RISERS

HOUSE CHANGED TO NO BASEMENT & ONLY ONE TANK INSTALLED AS SHOWN BELOW. HAVE MORE EASY ROOM IN FRONT OF HOUSE

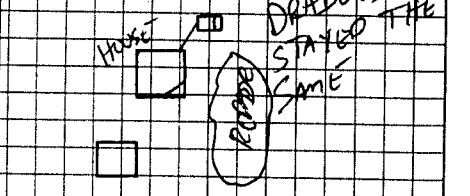

Permit can be suspended or revoked if any false information is supplied toward securing the permit and/or any unauthorized changes are made to the site/and unauthorized changes are made in the installation of the system. Improvement Permit with plat valid without expiration. Improvement Permit with site plan valid for sixty months. Authorization to Construct is valid for a period equal to that of Improvement Permit – not to exceed sixty months.

Signed: [signature] date 9-19-01 Installed by: DAVID YOUNT

Improvement Permit by: [signature] date 9-17-01 Operation Permit by: [signature] date 06-24-02

Authorization to Construct by: [signature] date 9-17-01 Existing System Inspection by: date

HEALTH DEPT. COPY: WHITE OWNER COPY (FINAL): YELLOW OWNER COPY (INITIAL): PINK