This drawing replaces permit issued 8/23/04

IREDELL COUNTY HEALTH DEPARTMENT CI

STATESVILLE 704-878-5305 MOORESVILLE 704-664-5281

IMPROVEMENT PERMIT / AUTHORIZATION TO CONSTRUCT / OPERATION PERMIT / EXISTING SYSTEM INSPECTION

PERMIT# 123184 PIN# 4757-04-2296 DATE 4-30-07

OWNER OR APPLICANT Ryan Newman PHONE: Business 910 788 4094 Home

ADDRESS 8300 Chaplin Ln. Sherrills Ford

LOCATION Hwy 21 N TL Jennings 7/10 m. on right

SUBDIVISION n/a BLOCK / SECTION LOT LOT AREA 64.36 SITE CLASS. PS DESIGN FLOW 480 L.T.A.R. .30

Septic Tank: 1000 Gallons; STB 1100 Date 3-2-07

Pump Tank: 1000 Gallons; PT 3 Date 2-22-7

Pump Make: Myers Model Serial No.

Nitrification Field: No Fields 1 Square Feet 1600 Linear Feet 400

No Lines 4 Trench Width 36" Max Trench Bottom Depth 36'

☒ New System ☐ Repair ☐ Expansion System Type: I II III IV V VI

System Description: Pump 25% Reduction

Repair System Description: Pump 25% Reduction

Maintenance Agreement Required: ☐ Yes ☒ No

☒ House/Mod. Home ☐ Mobile Home ☐ Business ☐ Other

No. Bedrooms 4 No. Persons No. Employees

Water Supply: ☐ Individual ☒ Public ☐ Community

Gravel Depth n/a ☐ Gravity ☒ Pressure ☐ Slab ☐ Crawl Space ☒ Basement w/plumbing ☐ Basement wo/plumbing

Comments/Conditions: Install sewage lift pump where plumbing comes out from house. Supply line from lift pump to septic may come no closer than 10' from lake

Comments/Conditions: Red Flite

INITIAL SITE SKETCH

attached soil diagram

AS BUILT SKETCH

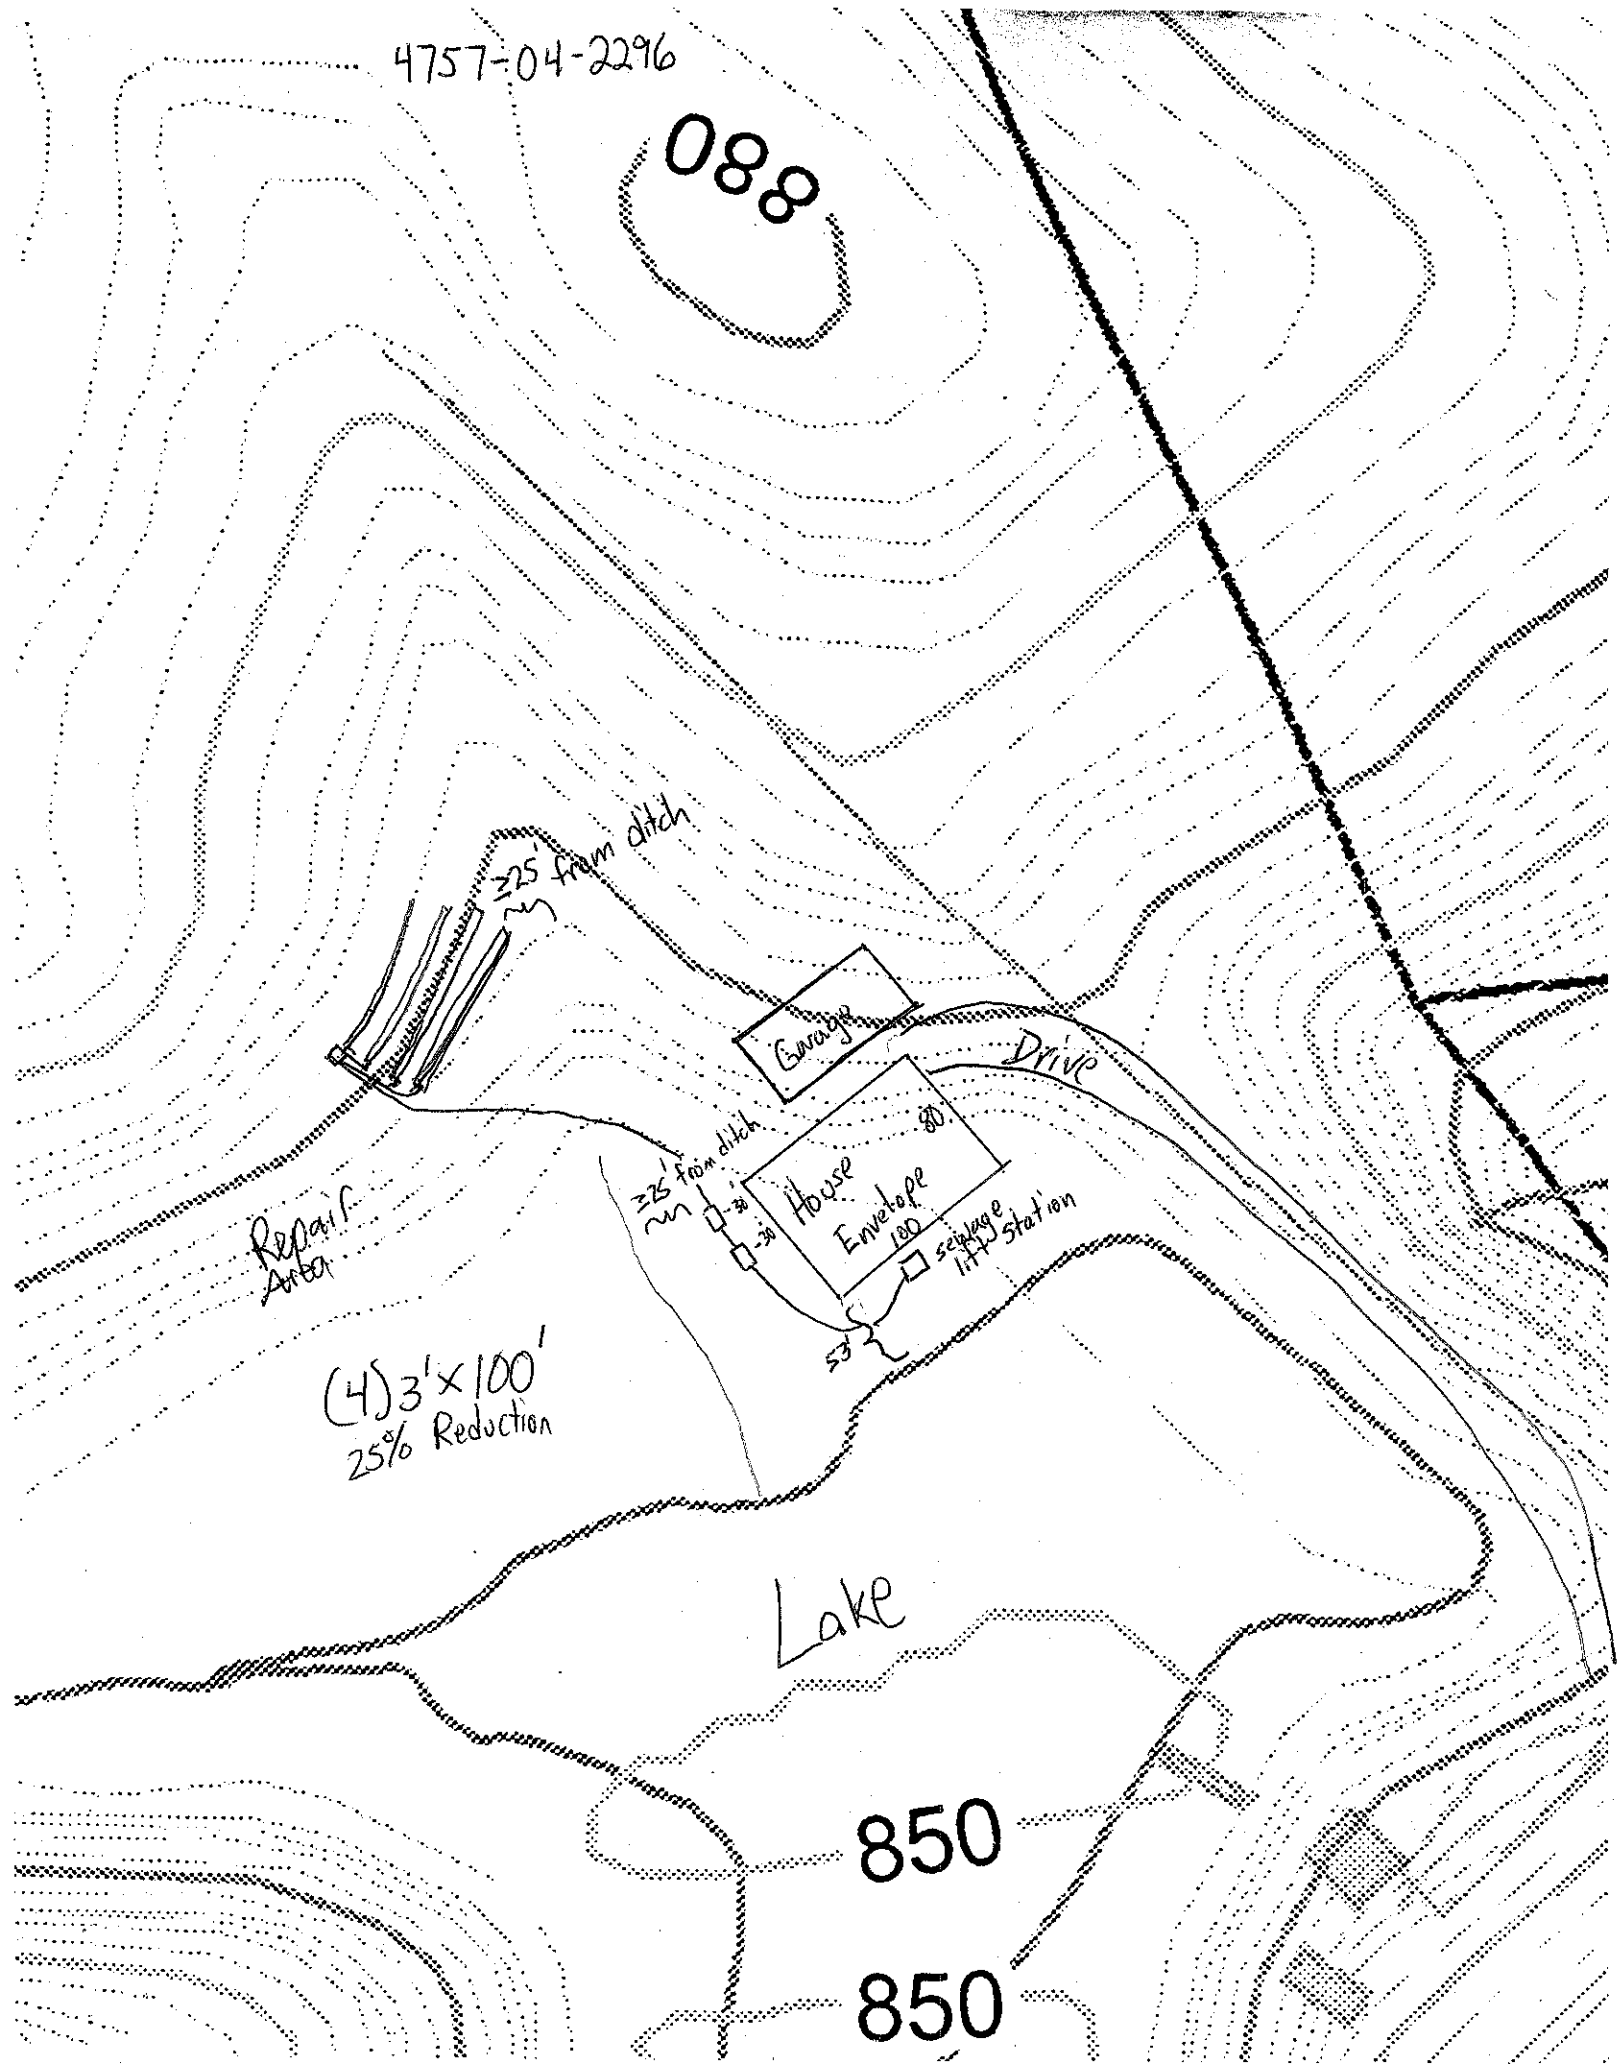
Permit can be suspended or revoked if any false information is supplied toward securing the permit/any unauthorized changes are made to the site/any unauthorized changes are made in the installation of the system. Improvement Permit with plat valid without expiration ☐ Improvement Permit with site plan valid for sixty months ☒ Authorization to Construct is valid for a period equal to that of Improvement Permit – not to exceed sixty months.

Signed: Billy Parker date 5/3/07 Installed by: Master Jones Backhoe

Improvement Permit by: date 5-2-07 Operation Permit by: date 11/9/07

Authorization to Construct by: date 5-2-07 Existing System Inspection by: date

HEALTH DEPT. COPY: WHITE OWNER COPY (FINAL): YELLOW OWNER COPY (INITIAL): PINK


4757-04-2296
088
≥25' from ditch
Garage
Drive
≥25' from ditch
House
Envelope
100
80'
30'
30'
sewage lift station
53'
Repair Area
(4) 3'x100'
25% Reduction
Lake
850
850