This drawing replaces permit issued 8/23/04

IREDELL COUNTY HEALTH DEPARTMENT

STATESVILLE 704-878-5305 MOORESVILLE 704-664-5281

IMPROVEMENT PERMIT / AUTHORIZATION TO CONSTRUCT / OPERATION PERMIT / EXISTING SYSTEM INSPECTION

PERMIT# 123184 PIN# 4757-04-2296 DATE 4-30-07

OWNER OR APPLICANT Ryan Newman PHONE: Business 910 788 4094 Home

ADDRESS 8300 Chapin Ln. Sherrills Ford

LOCATION Hwy 21 N TL Jennings 7/10 mi on right

SUBDIVISION n/a BLOCK / SECTION LOT LOT AREA: 64 36 SITE CLASS: PS DESIGN FLOW 480 L.T.A.R. .30

Septic Tank: 1000 Gallons: STB 1100 Date 3-2-07
Pump Tank: 1000 Gallons: PT 3 Date 2-22-7
Pump Make: Myers Model Serial No.
Nitrification Field: No Fields 1 Square Feet 1600 Linear Feet 400
No Lines 4 Trench Width 36" Max Trench Bottom Depth 36"

☒ New System ☐ Repair ☐ Expansion System Type: I II (III) IV V VI
System Description: Pump 25% Reduction
Repair System Description: Pump 25% Reduction
Maintenance Agreement Required: ☐ Yes ☒ No

☒ House/Mod. Home ☐ Mobile Home ☐ Business ☐ Other
No. Bedrooms 4 No. Persons No. Employees


Water Supply: ☐ Individual ☒ Public ☐ Community

Gravel Depth n/a ☐ Gravity ☒ Pressure ☐ Slab ☐ Crawl Space ☒ Basement w/plumbing ☐ Basement wo/plumbing


Comments/Conditions: Install sewage lift pump where plumbing comes out from house. Supply line from lift pump to septic may come no closer than 10' from lake

Comments/Conditions: Red Echo

INITIAL SITE SKETCH

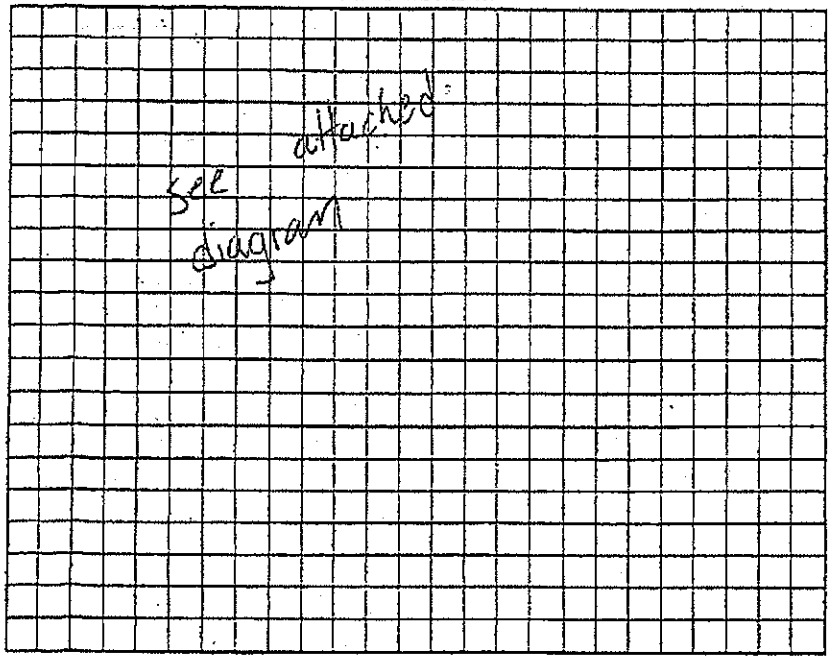

AS BUILT SKETCH

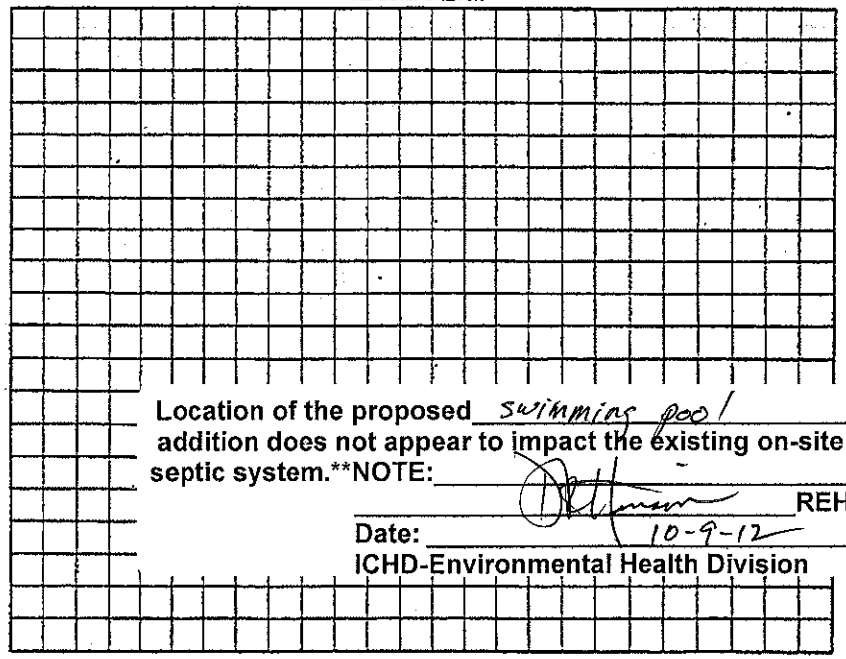

Location of the proposed swimming pool addition does not appear to impact the existing on-site septic system.**NOTE:

REHS

Date: 10-9-12

ICHD-Environmental Health Division

Permit can be suspended or revoked if any false information is supplied toward securing the permit/any unauthorized changes are made to the site/any unauthorized changes are made in the installation of the system. Improvement Permit with plat valid without expiration ☐ Improvement Permit with site plan valid for sixty months ☒ Authorization to Construct is valid for a period equal to that of Improvement Permit – not to exceed sixty months.

Signed: [signature] date 5/3/07

Improvement Permit by: [signature] date 5-2-07


Authorization to Construct by: [signature] date 5-2-07

Installed by: Master Cooty Backhoe

Operation Permit by: [signature] date 11/9/07

Existing System Inspection by: date

HEALTH DEPT. COPY: WHITE OWNER COPY (FINAL): YELLOW OWNER COPY (INITIAL): PINK

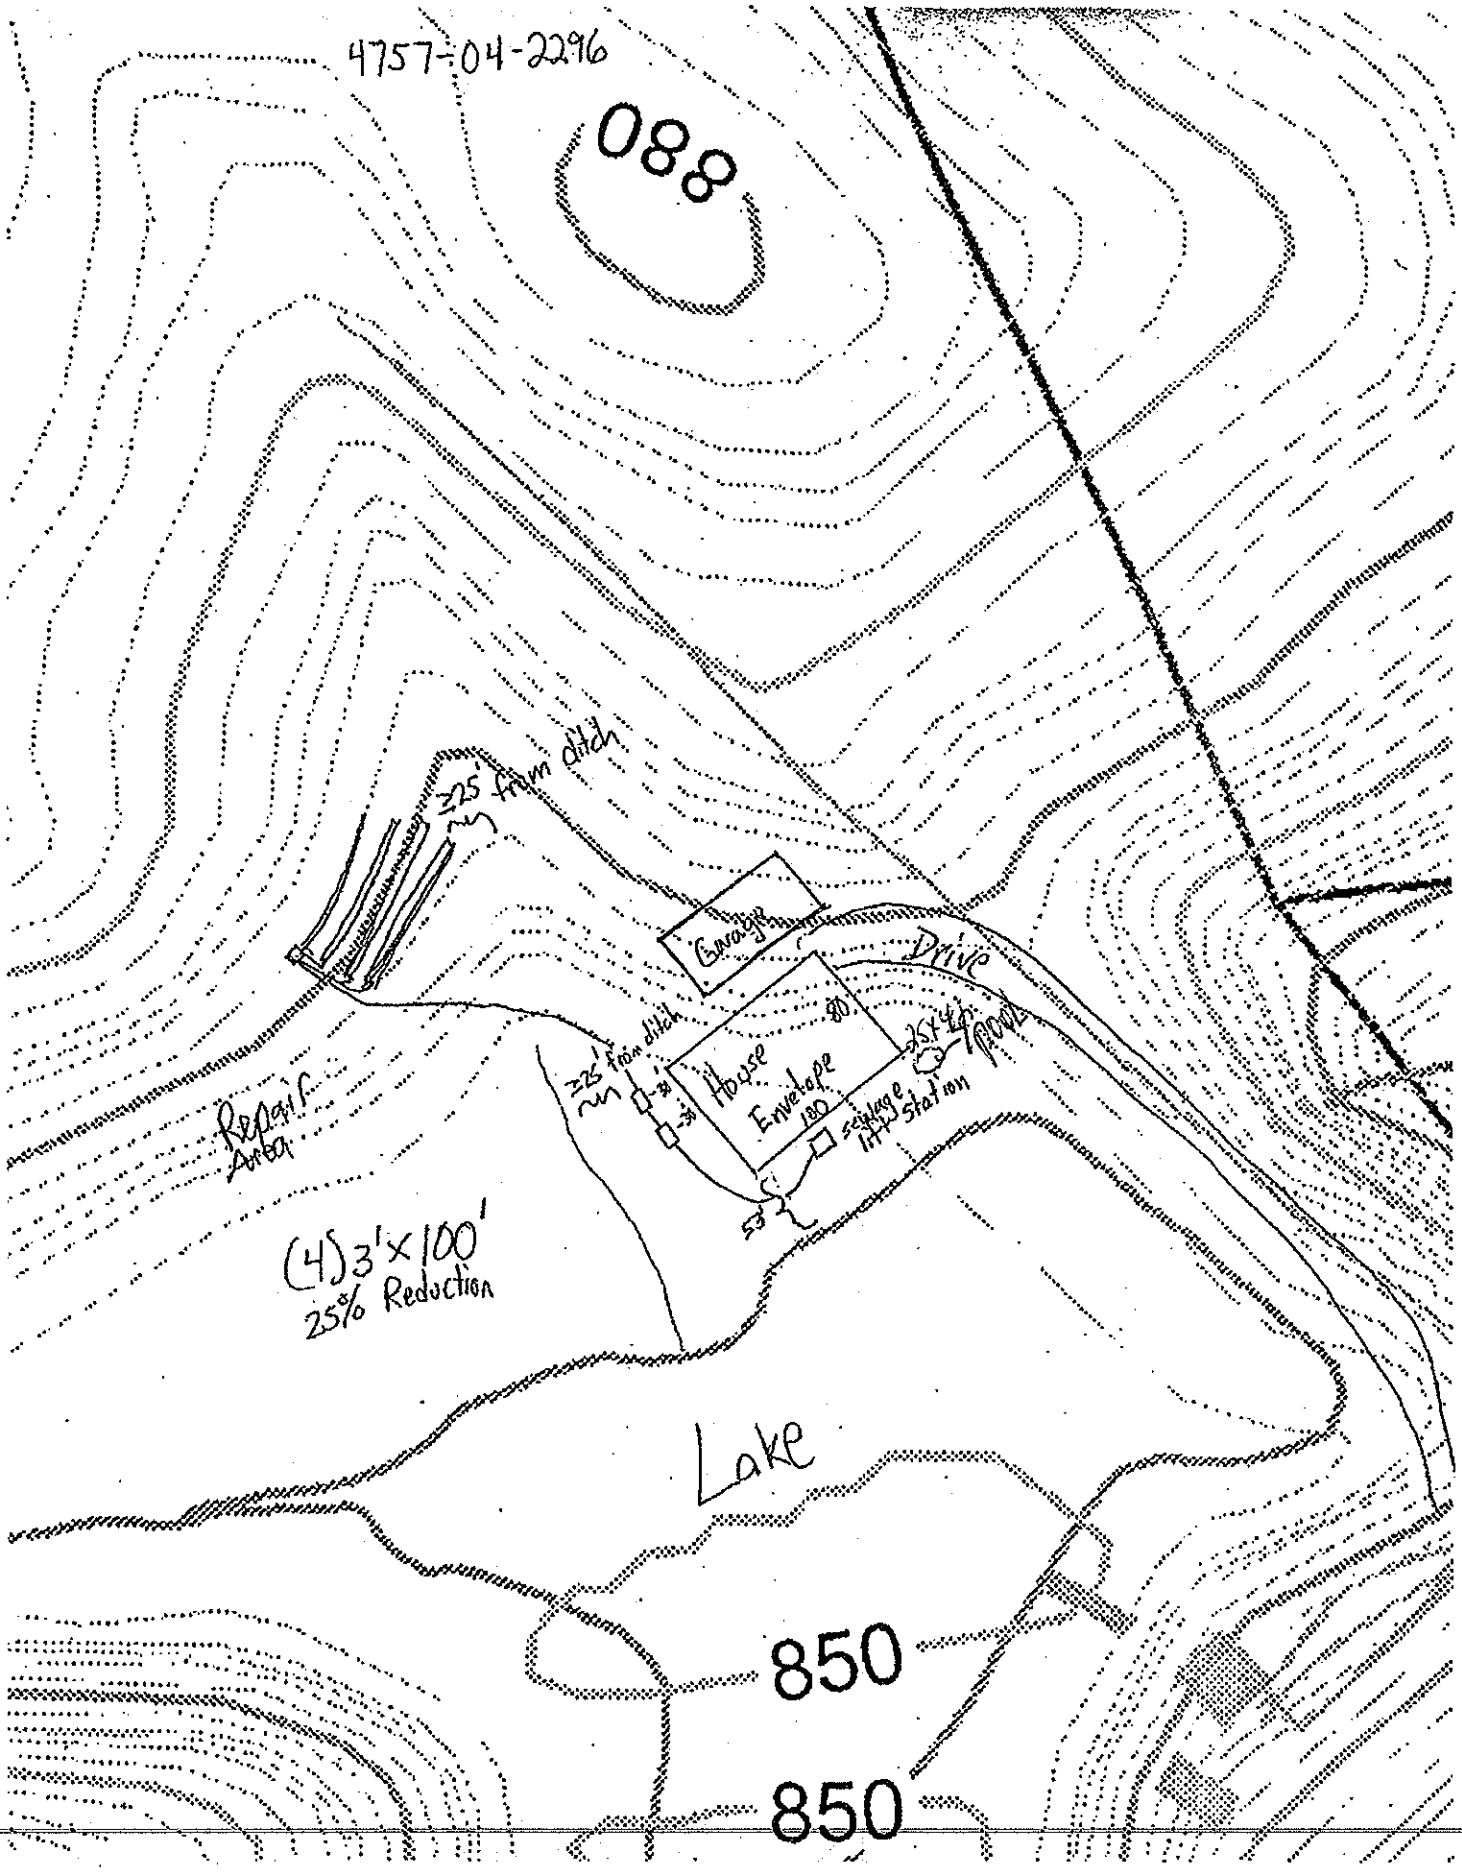
4757-04-2296
088
≥25' from ditch
Garage
Drive
≥25' from ditch
House Envelope 180
80'
25'x40' Pool
Septage Inspection Station
Repair Area
(4) 3'x100'
25% Reduction
Lake
850
850