47908

IREDELL COUNTY HEALTH DEPARTMENT

STATESVILLE 704-878-5305 MOORESVILLE 704-664-5281

IMPROVEMENT PERMIT / CERTIFICATE OF COMPLETION / OPERATION PERMIT / EXISTING SYSTEM INSPECTION

PROPERTY DESCRIPTION NO. 16618 DATE 7-7-93 PHONE: Business _____ TAX MAP NO. 10K-A-75
OWNER OR CONTRACTOR Wayne Blackwelder Home 8461613
ADDRESS Rt 4 Box 355C Statesville
LOCATION 21N To Jennings TR Beaver 1½ mi on Rt At Dairy Farm
SUBDIVISION _____ BLOCK / SECTION _____ LOT _____ LOT AREA 200 x 200 SITE CLASS. PS L.T.A.R. .4


Water Supply: ☑ Individual ☐ Community ☐ Public
Septic Tank: EX Gallons; STB _____ Date _____
Pump Tank: _____ Gallons; PT _____ Date _____
Nitrification Field: No Fields 1 Square Feet 450 Linear Feet 150
No Lines 2 Trench Width 36 Trench Depth 24 Gravel Depth 12
☐ New System ☐ Repair System Type: I. II. III. IV. V. VI
System Description: Addition Conv Gravity
Repair System Description: _____
Maintenance Agreement Required: ☐ Yes ☑ No

☑ House/Mod. Home No. Bedrooms 4
☐ Mobile Home No. Bathrooms 3
☐ Business No. Employees _____
☐ Other _____
☐ Slab ☐ Crawl Space ☐ Basement w/plumbing ☐ Basement wo/plumbing

Garbage Disposal: ☑ Yes ☐ No
Auto. Dishwasher: ☑ Yes ☐ No
Auto. Washing Machine: ☑ Yes ☐ No
Other _____

Comments Adding Top Story to Basement House
Adding To Total 4 bedrooms original systems installed 11-16-82 250' Drain line

INITIAL SITE SKETCH

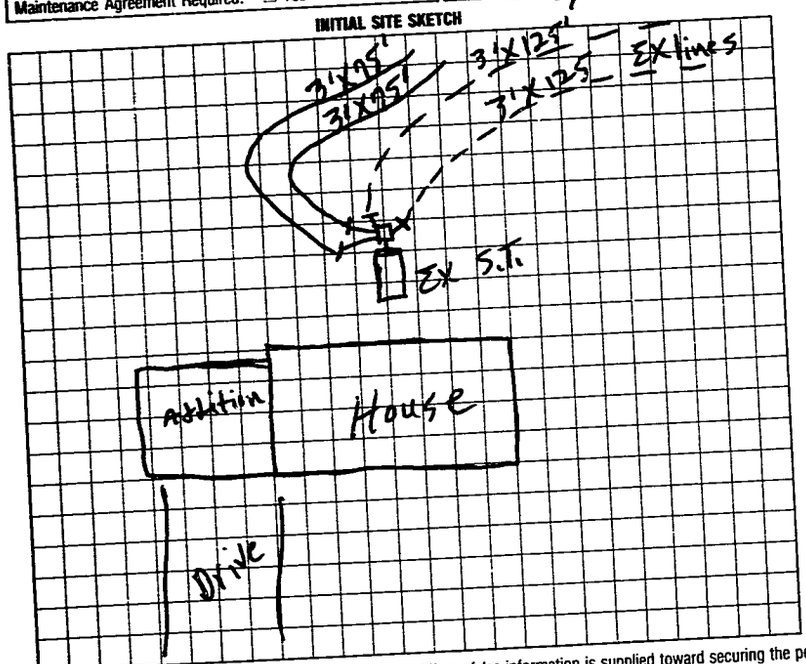

AS BUILT SKETCH

Same as initial Sketch

I understand that this permit can be suspended or revoked if any false information is supplied toward securing the permit/any unauthorized changes are made to the site/any unauthorized changes are made in the installation of the system.
Improvement Permit is valid for 60 months from date of issuance.

Signed: David Wayne Blackwelder
Improvement Permit by: P.C. Moore date 7-7-93
Existing System Inspection by: _____ date _____
Installed by: Tommy Frye
Certificate of Completion by: P.C. Moore date 11-29-92
Operation Permit by: _____ date _____

HEALTH DEPT. COPY: WHITE INSPECTION COPY (FINAL): GREEN OWNER COPY (FINAL): YELLOW INSPECTION COPY (INITIAL): PINK OWNER COPY (INITIAL): GOLD