CI / CI

IREDELL COUNTY HEALTH DEPARTMENT

STATESVILLE 704-878-5305 MOORESVILLE 704-664-5281

IMPROVEMENT PERMIT / AUTHORIZATION TO CONSTRUCT / OPERATION PERMIT / EXISTING SYSTEM INSPECTION

PERMIT# 105335 PIN# 4757-07-0579 DATE 04-22-02

OWNER OR CONTRACTOR MIKE LUNDY PHONE Business 704-880-8715 Home 704-876-6009

ADDRESS 106 RIVER OAKS DRIVE STATESVILLE NC 28677

LOCATION HWY 21 NORTH, (L) JENNINGS, (R) REEVES, (L) RYDELL, 4TH LOT ON LEFT

SUBDIVISION AMBLESIDE II BLOCK / SECTION ____ LOT 4 LOT AREA .51 AC SITE CLASS PS DESIGN FLOW 360 L.T.A.R. .3

Septic Tank: 1000 Gallons: STB 1017 Date 02-05-02
Pump Tank: ____ Gallons: PT ____ Date ____
Pump Make: ____ Model ____ Serial No. ____
Nitrification Field: No Fields 1 Square Feet 1200' Linear Feet 300'
No Lines 6 Trench Width 36" Max Trench Bottom Depth 36" Gravel Depth N/A

[X] New System [ ] Repair System Type: I, II, III, IV, V, VI
System Description: GRAY 2540 REG
Repair System Description: LP PANEL
Maintenance Agreement Required: [ ] Yes [X] No
[ ] Slab [X] Crawl Space [ ] Basement w/plumbing [ ] Basement wo/plumbing


[X] House/Mod. Home No. Bedrooms 3
[ ] Mobile Home No. Bathrooms 2
[ ] Business No. Employees ____
[ ] Other ____

Water Supply: [ ] Individual [X] Public [ ] Community


Comments/Conditions: (1) LAST 40' LINE CAN HAVE DROP BOX IF CONTRACTOR WANTS IT (2) MAINTAIN SETBACKS - 15' OFF CUT BANK WITH LINES (3) USE FLOW DIVIDER TEE & DROP BOXES (4) INSTALL LINES ON CONTOUR.

Comments/Conditions: (5) INSTALL H2O LINE 10' FROM SYSTEM PVC TO FILTER & MANIFOLD. INSTALLED AS SHOWN

INITIAL SITE SKETCH

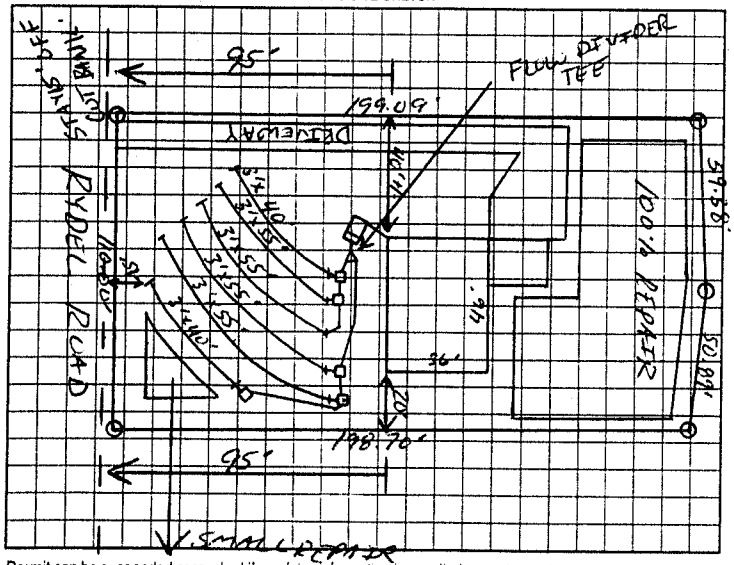

AS BUILT SKETCH

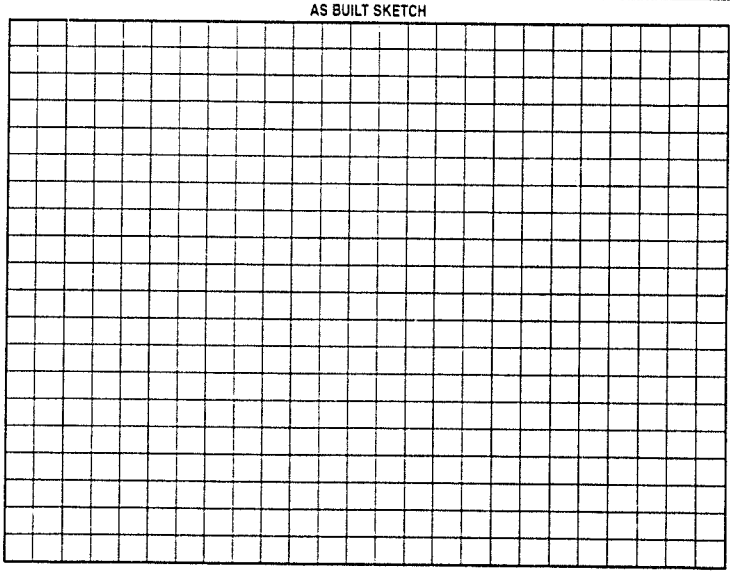

Permit can be suspended or revoked if any false information is supplied toward securing the permit/any unauthorized changes are made to the site any unauthorized changes are made in the installation of the system. Improvement Permit with plat valid without expiration. Improvement Permit with site plan valid for sixty months. Authorization to Construct is valid for a period equal to that of Improvement Permit - not to exceed sixty months.

Signed: [signature] date 04/22/02 Installed by STEVE JORDAN

Improvement Permit by: [signature] date 04-22-02 Operation Permit by: [signature] date 06-12-02

Authorization to Construct by: [signature] date 04-22-02 Existing System Inspection by: ____ date ____

HEALTH DEPT COPY: WHITE OWNER COPY (FINAL): YELLOW OWNER COPY (INITIAL): PINK