IREDELL COUNTY HEALTH DEPARTMENT

STATESVILLE 704-878-5305 MOORESVILLE 704-664-5281

IMPROVEMENT PERMIT / AUTHORIZATION TO CONSTRUCT / OPERATION PERMIT / EXISTING SYSTEM INSPECTION

PERMIT# 75909 PIN# 4757 07 2746 DATE 8-17-98

OWNER OR CONTRACTOR John Lunty PHONE: Business Home 8766009

ADDRESS 198 woodpecker Rd Statesville N.C.

LOCATION Hwy 21N To Jennings Rd TR Reeves Rd 2nd Rt on Left Rydelbn 1st lot Rt.

SUBDIVISION Ambleside BLOCK / SECTION II LOT 18 LOT AREA 122' X 224' SITE CLASS. P3 DESIGN FLOW 360 L.T.A.R. .35

Septic Tank: 1000 Gallons; STB Date

Pump Tank: Gallons; PT Date

Pump Make: Model Serial No.

Nitrification Field: No Fields 1 Square Feet 1035 Linear Feet 345

No Lines 3 Trench Width 36" Max Trench Bottom Depth 36" Gravel Depth

☑ New System ☐ Repair System Type: I, II, III, IV, V, VI

System Description: Conv. Gravity

Repair System Description: Gravity 250 gal.

Maintenance Agreement Required: ☐ Yes ☑ No

☑ House/Mod. Home ☐ Mobile Home ☐ Business ☐ Other

No. Bedrooms 3 No. Bathrooms 2 No. Employees

☐ Slab ☑ Crawl Space ☐ Basement w/plumbing ☐ Basement wo/plumbing


Water Supply: ☐ Individual ☑ Public ☐ Community

Comments:/Conditions:

Rydelbn.

Comments:/Conditions: THREE LINES AT ~105 FEET EACH INSTALLED DUE TO PROPERTY LINE SETBACK (TOTAL LINE ~315')

INITIAL SITE SKETCH

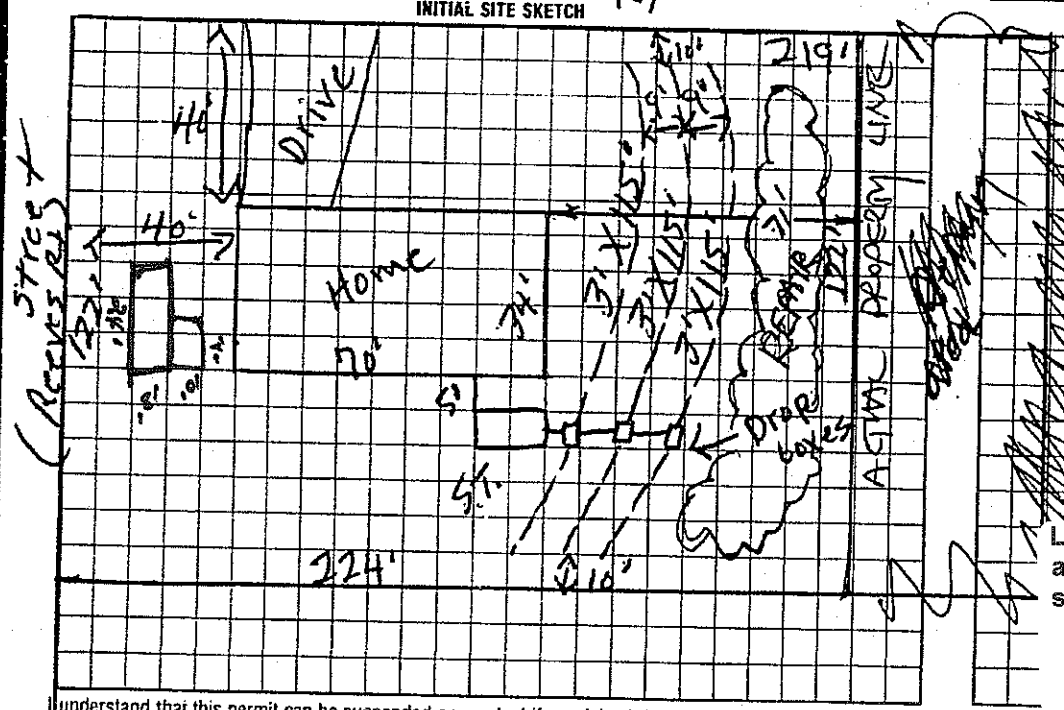

AS BUILT SKETCH

SYSTEM INSTALLED ACCORDING TO CONTRACT ABOVE & AS SHOWN

Location of the proposed outbuilding (16×24) addition does not appear to impact the existing on-site septic system.**NOTE:

REHS

Date: 1-10-12

ICHD-Environmental Health Division

I understand that this permit can be suspended or revoked if any false information is supplied toward securing the permit/any unauthorized changes are made to the site/any unauthorized changes are made in the installation of the system. Improvement Permit with plat valid without expiration. Improvement Permit with site plan valid for sixty months. Authorization to Construct is valid for a period equal to that of Improvement Permit – not to exceed sixty months.

Signed: X John Lunty date

Improvement Permit by: R. C. Moore date 8-17-98

Authorization to Construct by: R. C. Moore date 8-17-98

Installed by: A-1 BACKHOE

Operation Permit by: STEVE HEDRICK date 10-26-98

Existing System Inspection by: date

HEALTH DEPT. COPY: WHITE INSPECTION COPY (FINAL): GREEN OWNER COPY (FINAL): YELLOW INSPECTION COPY (INITIAL): PINK OWNER COPY (INITIAL): GOLD

1 5 2 0 0