IREDELL COUNTY HEALTH DEPARTMENT

STATESVILLE 704-878-5305 MOORESVILLE 704-664-5281

IMPROVEMENT PERMIT / AUTHORIZATION TO CONSTRUCT / OPERATION PERMIT / EXISTING SYSTEM INSPECTION

CT

PERMIT# 136517 PIN# 4757073956 DATE 8-2-06

OWNER OR APPLICANT Dixieland, Inc. PHONE: Business 704 202 4971 Home

ADDRESS 140 140 Rydel Ln

LOCATION Hwy 21 N, (R) on Jennings (R) on Reeves (L) on Rydel, property on R

SUBDIVISION Ambelside BLOCK / SECTION LOT 13 LOT AREA .651 SITE CLASS. PS DESIGN FLOW 360 L.T.A.R. .3

Septic Tank: 1000 Gallons: STB 825 Date 11-03-06
Pump Tank: Gallons: PT Date
Pump Make: Model Serial No.
Nitrification Field: No Fields 1 Square Feet 1200 Linear Feet 300
No Lines 4 Trench Width 36" Max Trench Bottom Depth 36" Gravel Depth n/a

☒ New System ☐ Repair ☐ Expansion System Type: I (II) III IV V VI
System Description: 25% Reduction - Gravity
Repair System Description: 25% Reduction - Pump
Maintenance Agreement Required: ☐ Yes ☒ No

☒ Gravity ☐ Pressure ☐ Slab ☒ Crawl Space ☐ Basement w/plumbing ☒ Basement wo/plumbing


☒ House/Mod. Home No. Bedrooms 3
☐ Mobile Home No. Persons
☐ Business No. Employees
☐ Other

Water Supply: ☐ Individual ☒ Public ☐ Community


Comments:/Conditions:

Comments:/Conditions:

INITIAL SITE SKETCH

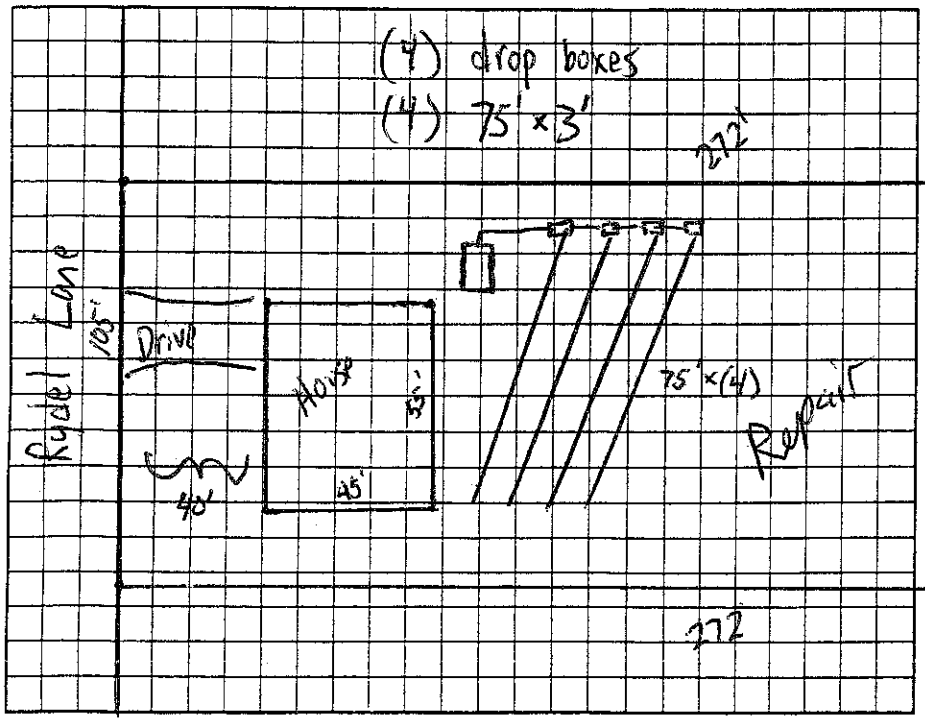

AS BUILT SKETCH

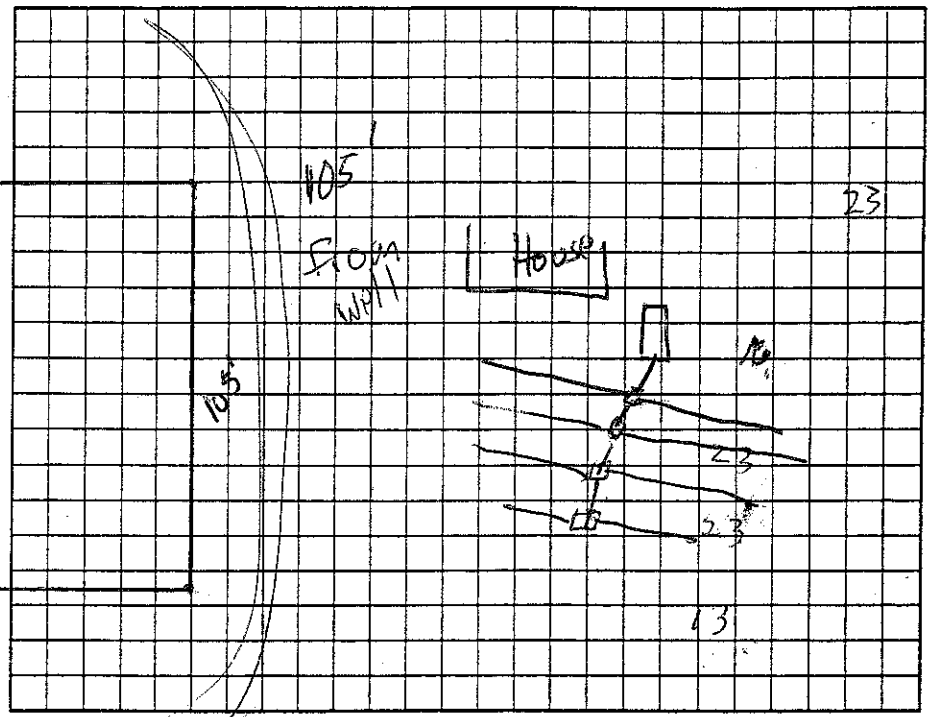

Permit can be suspended or revoked if any false information is supplied toward securing the permit/any unauthorized changes are made to the site/any unauthorized changes are made in the installation of the system. Improvement Permit with plat valid without expiration ☐ Improvement Permit with site plan valid for sixty months ☐ Authorization to Construct is valid for a period equal to that of Improvement Permit – not to exceed sixty months.

Signed: Gregory C Dowdle date

Improvement Permit by: James Allen date 8-2-06

Authorization to Construct by: James Allen date 9/14/06

Installed by: Rowan Septic

Operation Permit by: James Allen date 3-7-07

Existing System Inspection by: date

HEALTH DEPT. COPY: WHITE OWNER COPY (FINAL): YELLOW OWNER COPY (INITIAL): PINK