IREDELL COUNTY HEALTH DEPARTMENT

STATESVILLE 704-878-5305 MOORESVILLE 704-664-5281

IMPROVEMENT PERMIT / AUTHORIZATION TO CONSTRUCT / OPERATION PERMIT / EXISTING SYSTEM INSPECTION

PERMIT # 1584464 PIN # 4757-07-7786 DATE 12-1-09

OWNER or APPLICANT Eddie & Heather Thomas PHONE: Business Home: 704-872-0825

OWNER or APPLICANT ADDRESS 251 Reeves Road Statesville, NC 28625

LOCATION / DIRECTIONS 21 N to Jennings to Reeves to 251 Reeves RD

SUBDIVISION BLOCK / SECTION LOT # LOT AREA DESIGN FLOW 360 L.T.A.R. Exist

Septic Tank Exist Gallons: STB Date

Pump Tank Gallons: P T Date

Pump Make Model Serial #

Nitrification Field No Fields 1 No Lines 4 Linear Feet Exist

Trench Width Exist Max. Trench Bottom Depth Exist Gravel Depth Exist GRAVITY PRESSURE

☑ New System ☐ Repair ☐ Expansion System Type I II III IV V VI

System Description: Conventional Gravity

Repair System Description: 2590 Gravity

Maintenance Agreement Required ☐ YES ☑ NO

☐ Residence No. Bedrooms 3

☐ Business No. Persons

☐ Other No. Employees

☐ Slab ☑ Crawl Space

☐ Basement w/plumbing ☐ Basement w/o plumbing

Water Supply: ☐ Private ☑ Public ☐ Community


Comments / Conditions

New Garage does not impose on Existing Septic.


Comments / Conditions

New Property line Survey attached

INITIAL SITE SKETCH

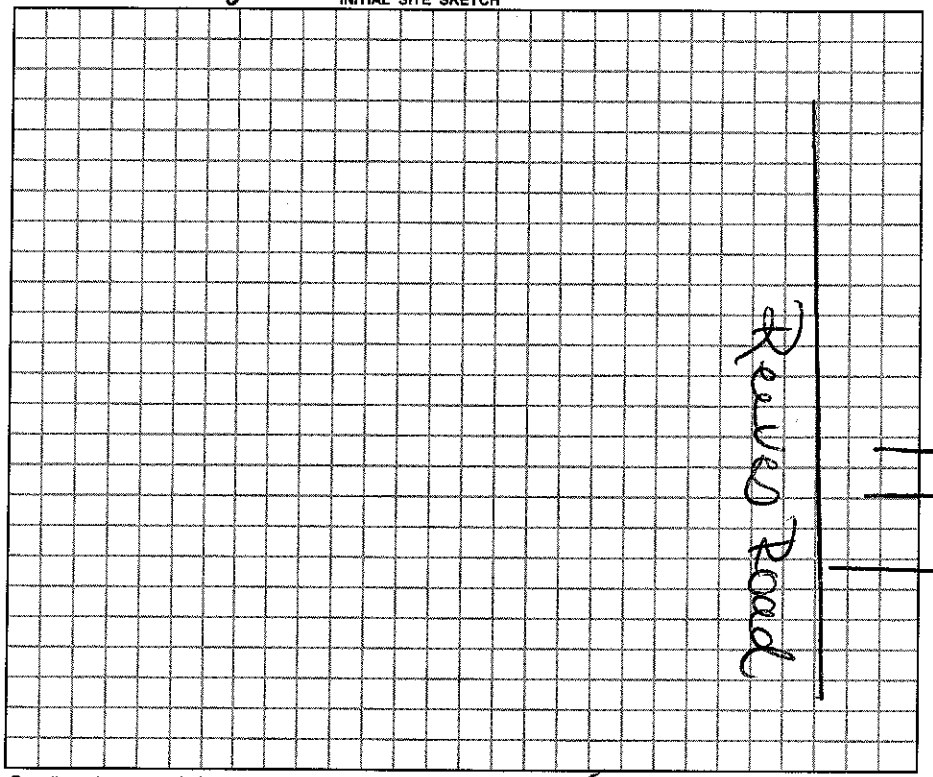

AS BUILT SKETCH

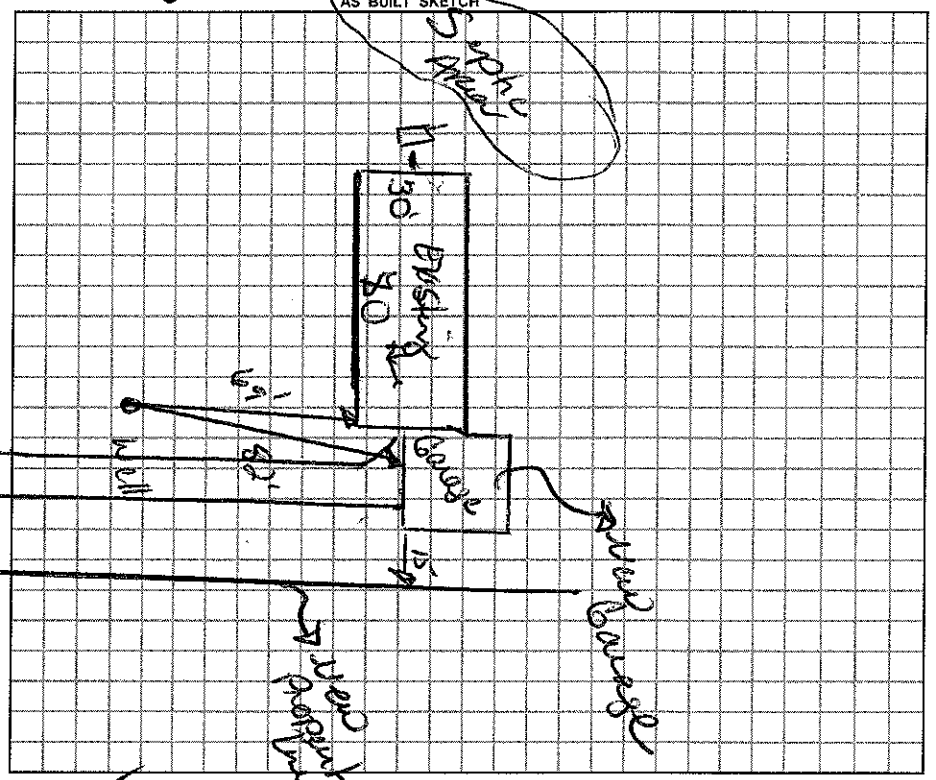

Permit can be suspended or revoked if any false information is supplied toward securing the permit / any unauthorized changes are made to the site / any unauthorized changes are made in the installation of the system.

☐ *IMPROVEMENT PERMIT w / plat valid without expiration.* ☑ *IMPROVEMENT PERMIT w / site plan valid for 60 mos.* ☑ *AUTHORIZATION TO CONSTRUCT valid for period equal to IMPROVEMENT PERMIT-not to exceed 60 mo.*

Owner / Applicant Signature: Hayden Hanby Jr Date 12-3-09

Improvement Permit by: Date

Authorzation to Construct by: Date

YOU SHOULD CONTACT A LOCATOR SERVICE PRIOR TO ANY EXCAVATION.

Installed by:

Operation Permit by: Date:

Existing System Inspected by: Kelly Cook Date: 12-1-09

WHITE COPY Environmental Health YELLOW COPY (Final) Owner / Applicant PINK COPY (Initial) Owner / Applicant