IREDELL COUNTY HEALTH DEPARTMENT

STATESVILLE 704-878-5305 MOORESVILLE 704-664-5281

IMPROVEMENT PERMIT / AUTHORIZATION TO CONSTRUCT / OPERATION PERMIT / EXISTING SYSTEM INSPECTION

PERMIT# 92256 PIN# 4754 08 1002 DATE 10-3-00

OWNER OR CONTRACTOR John C. Lunsford PHONE: Business Home

ADDRESS 198 Woodpecker Statesville

LOCATION 21N TL Jennings TR Reeves TL Ryte/ at end on left

SUBDIVISION Amfelside BLOCK / SECTION 2 LOT 8 LOT AREA 1.49 acres SITE CLASS PS DESIGN FLOW 360 L.T.A.R. 1.35

Septic Tank: 1000 Gallons; STB 1012 Date 10-30-00

Pump Tank: Gallons; PT Date

Pump Make: Model Serial No.

Nitrification Field: No. Fields 1 Square Feet 1035 Linear Feet 345

No. Lines 4 Trench Width 36" Max Trench Bottom Depth 36" Gravel Depth 12"

☑ New System ☐ Repair System Type: I, II, III, IV, V, VI

System Description: Conv. Gravity pump pipe

Repair System Description:

Maintenance Agreement Required: ☐ Yes ☐ No

☐ House/Mod. Home No. Bedrooms 3

☐ Mobile Home No. Bathrooms 2

☐ Business No. Employees

☐ Other


☐ Slab ☒ Crawl Space ☐ Basement w/plumbing ☐ Basement wo/plumbing

Water Supply: ☐ Individual ☐ Public ☐ Community

Comments:/Conditions:

Comments /Conditions:

INITIAL SITE SKETCH 193'

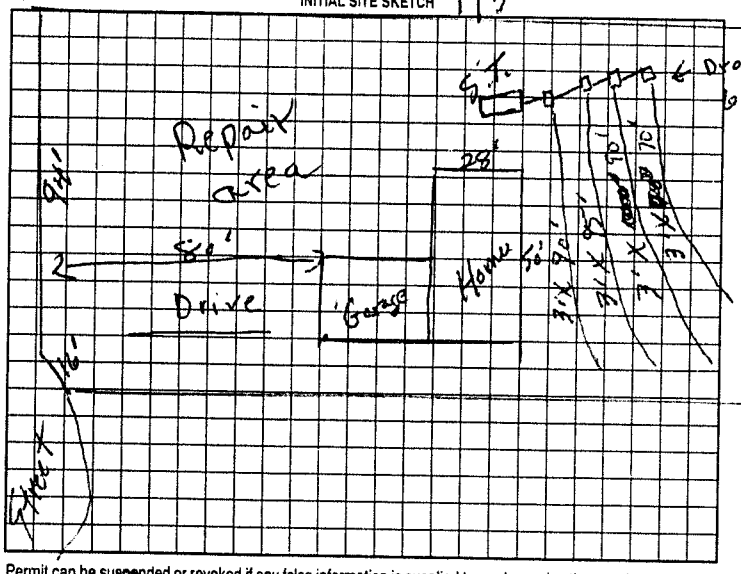

AS BUILT SKETCH

INSTALLED AS SHOWN WITH RECORD FILTER UNMARKED

Permit can be suspended or revoked if any false information is supplied toward securing the permit/any unauthorized changes are made to the site/any unauthorized changes are made in the installation of the system. Improvement Permit with plat valid without expiration. Improvement Permit with site plan valid for sixty months. Authorization to Construct is valid for a period equal to that of Improvement Permit – not to exceed sixty months.

Signed: John Lunsford date 10-3-00 Installed by: STEVE JORDAN

Improvement Permit by: D.C. Moore date 10-3-00 Operation Permit by: RST date 03-07-01

Authorization to Construct by: D.C. Moore date 10-3-00 Existing System Inspection by: date

HEALTH DEPT. COPY: WHITE OWNER COPY (FINAL): YELLOW OWNER COPY (INITIAL): PINK