IREDELL COUNTY HEALTH DEPARTMENT

STATESVILLE 704-878-5305 MOORESVILLE 704-664-5281

IMPROVEMENT PERMIT / AUTHORIZATION TO CONSTRUCT / OPERATION PERMIT / EXISTING SYSTEM INSPECTION

PERMIT# 101292 PIN# 4757-08-3067 DATE 7-16-01

OWNER OR CONTRACTOR MIKE LUNDY PHONE: Business _____ Home 704-871-9477

ADDRESS 146 RYDEL LN STATESVILLE, NC 28625

LOCATION 2 IN, ① JENNINGS, ② REEVES, ③ RYDEL, ON RT AT CUL-DE-SAC

SUBDIVISION AMBLESIDE BLOCK / SECTION _____ LOT 12 LOT AREA 0.699AC SITE CLASS PS DESIGN FLOW 360 L.T.A.R. .3

Septic Tank: 1000 Gallons: STB 1012 Date 4-9-01
Pump Tank: _____ Gallons; PT _____ Date _____
Pump Make: _____ Model _____ Serial No _____
Nitrification Field: No Fields 1 Square Feet 1200' Linear Feet 400'
No Lines 5 Trench Width 36" Max Trench Bottom Depth 36" Gravel Depth 12"

☒ New System ☐ Repair System Type: I. II. III. IV. V. VI
System Description: GRAV CONV
Repair System Description: GRAV 25% REDUCT
Maintenance Agreement Required: ☐ Yes ☒ No


☒ House/Mod. Home No. Bedrooms 3
☐ Mobile Home No. Bathrooms 2
☐ Business No. Employees _____
☐ Other _____
☐ Slab ☒ Crawl Space ☐ Basement w/plumbing ☐ Basement wo/plumbing

Water Supply: ☐ Individual ☒ Public ☐ Community

Comments/Conditions: ① INSTALL LINES ON CONTOUR ② MAINTAIN SETBACKS ③ USE 5 DROP BOXES

Comments/Conditions: 1ST 3 LINES L'D OK ④ TANK ALSO OK! 4+5 Laser okay by
- Poly Lok Filter Installed

INITIAL SITE SKETCH 1" = 50'

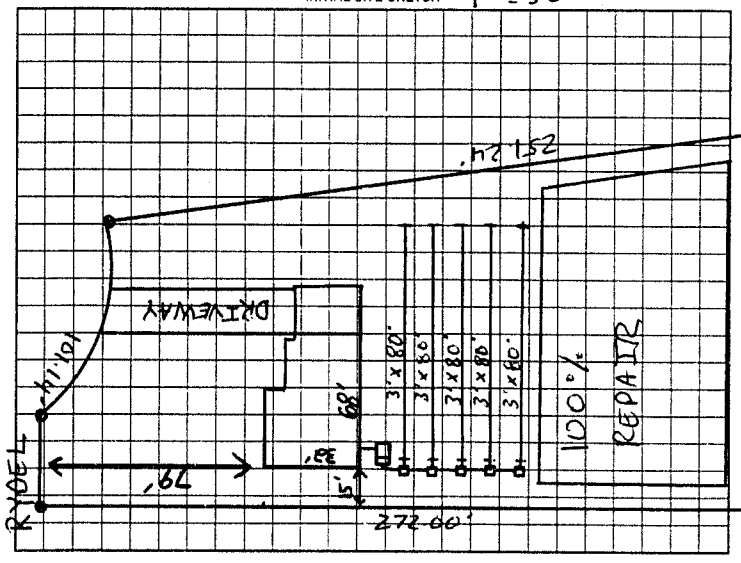

AS BUILT SKETCH

- Septic Tank Marker Installed

Installed as Shown per Initial Site Sketch

Permit can be suspended or revoked if any false information is supplied toward securing the permit/any unauthorized changes are made to the site/any unauthorized changes are made in the installation of the system. Improvement Permit with plat valid without expiration. Improvement Permit with site plan valid for sixty months. Authorization to Construct is valid for a period equal to that of Improvement Permit – not to exceed sixty months.

Signed: Michael D Lundy date 7-17-01

Improvement Permit by: Jim Cook REHS date 7-16-01

Authorization to Construct by: Jim Cook REHS date 7-16-01

Installed by: Steve Jordan

Operation Permit by: William O. Johnson date 8/24/01

Existing System Inspection by: _____ date _____

HEALTH DEPT COPY: WHITE OWNER COPY (FINAL): YELLOW OWNER COPY (INITIAL): PINK