IREDELL COUNTY HEALTH DEPARTMENT

STATESVILLE 704-878-5305 MOORESVILLE 704-664-5281

IMPROVEMENT PERMIT / AUTHORIZATION TO CONSTRUCT / OPERATION PERMIT / EXISTING SYSTEM INSPECTION

PERMIT# 83866 PIN# 4757096639 DATE 6-23-00

OWNER OR CONTRACTOR Archie Bridges PHONE: Business Home 876 2030

ADDRESS 736 Blackwelder Rd

LOCATION 21N TO Jennings Rd TR Blackwelder Rd 1½ mi TR Bridges Creek Rd at end on rt.

SUBDIVISION Bent Creek BLOCK / SECTION POT 13 & 13A LOT AREA 1.16 acres SITE CLASS PS DESIGN FLOW 360 L.T.A.R. .25 gal/sq ft/day

Septic Tank: 1000 Gallons; STB 1012 Date 4-4-00
Pump Tank: Gallons; PT Date
Pump Make: Model Serial No
Nitrification Field: No. Fields 1 Square Feet 480 Linear Feet 240
No. Lines 3 Trench Width 24" Max Trench Bottom Depth 36" Gravel Depth N/A


☐ New System ☐ Repair System Type: I, II, (III), IV, V
System Description: Gravity 50% Reduction Area
Repair System Description: Pump to 25% Reducting Panels
Maintenance Agreement Required: ☐ Yes ☑ No

☐ House/Mod. Home ☑ Mobile Home ☐ Business ☐ Other
No. Bedrooms 3 No. Bathrooms No. Employees
☐ Slab ☑ Crawl Space ☐ Basement w/plumbing ☐ Basement wo/plumbing

Water Supply: ☐ Individual ☑ Public ☐ Community


Comments/Conditions:

INITIAL SITE SKETCH

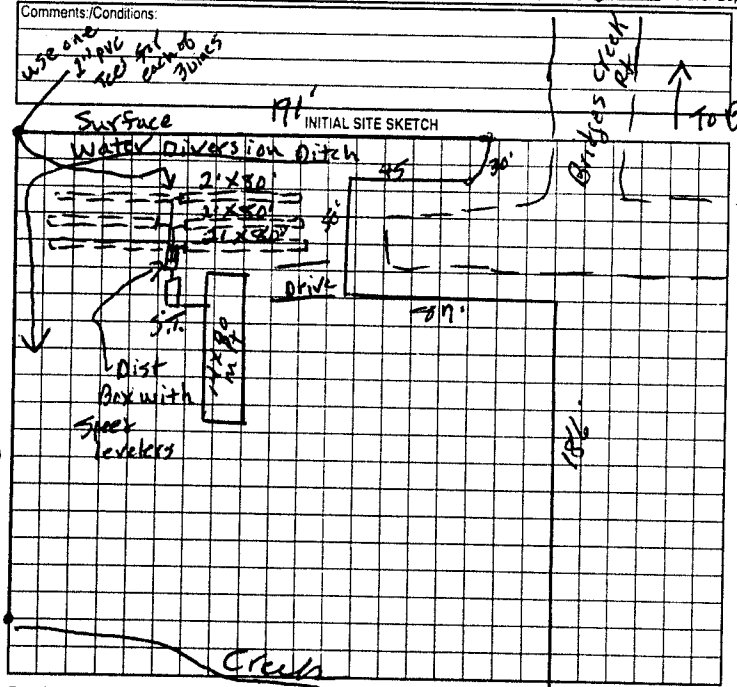

Comments/Conditions:
Lot 13 A at the corner of Blackwelder Rd & Bridges Creek Rd will be used for the Repair area. It is treated with Lot 13 for off site Repair area

AS BUILT SKETCH

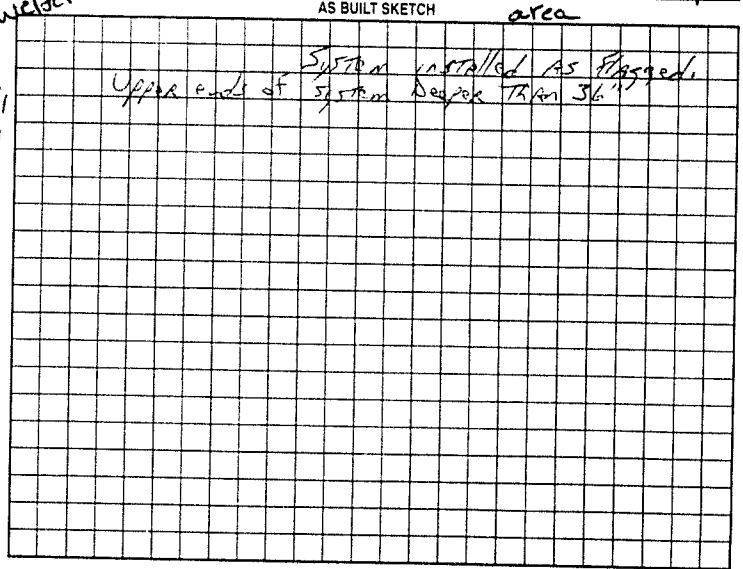

210'

Permit can be suspended or revoked if any false information is supplied toward securing the permit/any unauthorized changes are made to the site/any unauthorized changes are made in the installation of the system. Improvement Permit with plat valid without expiration. Improvement Permit with site plan valid for sixty months. Authorization to Construct is valid for a period equal to that of Improvement Permit – not to exceed sixty months.

Signed: date 6-30-00 Installed by: Tommy Kaye

Improvement Permit by: P.C. Moore date 6-23-00 Operation Permit by: date

Authorization to Construct by: P.C. Moore date 6-23-00 Existing System Inspection by: date

HEALTH DEPT. COPY: WHITE OWNER COPY (FINAL): YELLOW OWNER COPY (INITIAL): PINK