IREDELL COUNTY HEALTH DEPARTMENT

STATESVILLE 704-878-5305 MOORESVILLE 704-664-5281

IMPROVEMENT PERMIT / AUTHORIZATION TO CONSTRUCT / OPERATION PERMIT / EXISTING SYSTEM INSPECTION

PERMIT# 73207 PIN# 4758 DATE 5-12-98

OWNER OR CONTRACTOR Archie G. Bridges PHONE: Business Home 876 2030

ADDRESS 736 Blackwelder Road Statesville, N.C.

LOCATION 21 N to Jennings Rd TR Blackwelder Rd TR Bridges Creek at end RT

SUBDIVISION Bent Creek BLOCK / SECTION LOT 14 LOT AREA 1.55 acres SITE CLASS. PS DESIGN FLOW 336 L.T.A.R. .28

Septic Tank: 1000 Gallons; STB 1012 Date 12-28-98

Pump Tank: Gallons; PT Date

Pump Make: Model Serial No.

Nitrification Field: No Fields 1 Square Feet 900 Linear Feet 300

No Lines 3 Trench Width 36" Max Trench Bottom Depth 36" Gravel Depth 12"

[X] New System [ ] Repair System Type: I, II, III, IV, V, VI

System Description: Conv. Gravity

Repair System Description: " "

Maintenance Agreement Required: [ ] Yes [X] No

[ ] Slab [X] Crawl Space [ ] Basement w/plumbing [ ] Basement wo/plumbing

[ ] House/Mod. Home No. Bedrooms 2

[X] Mobile Home No. Bathrooms 2

[ ] Business No. Employees


[ ] Other

Water Supply: [ ] Individual [X] Public [ ] Community


Comments:/Conditions:

Comments:/Conditions:

INITIAL SITE SKETCH 189'

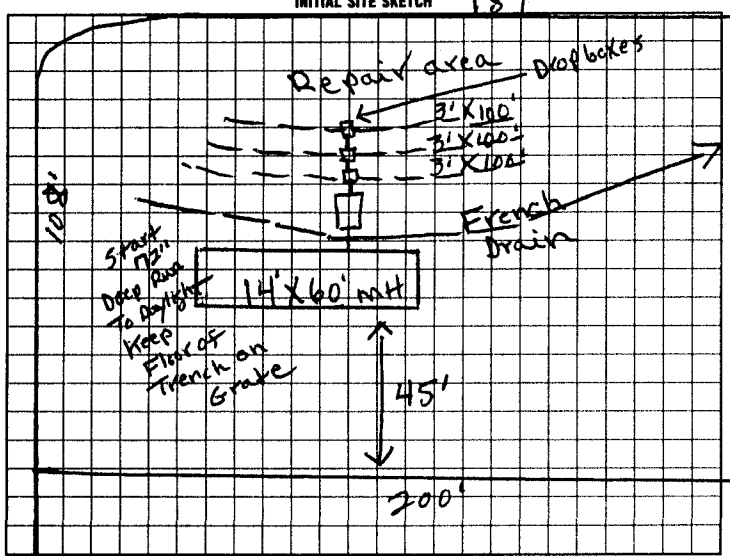

AS BUILT SKETCH

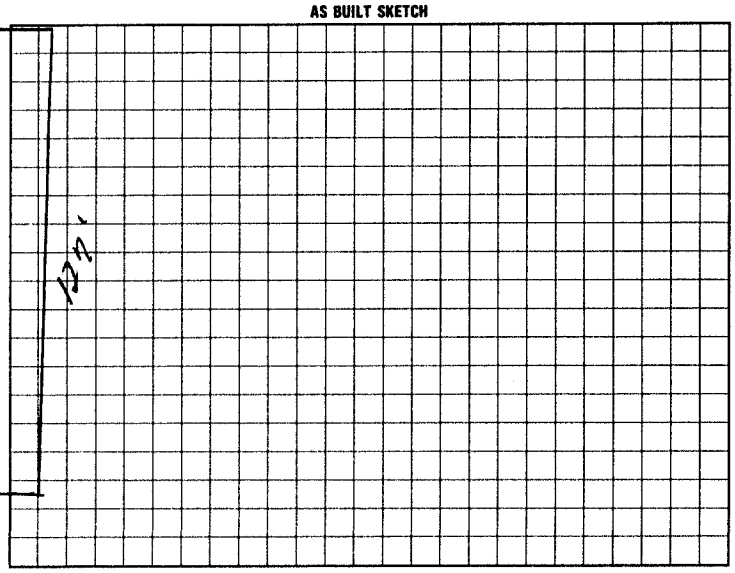

I understand that this permit can be suspended or revoked if any false information is supplied toward securing the permit/any unauthorized changes are made to the site/any unauthorized changes are made in the installation of the system. Improvement Permit with plat valid without expiration. Improvement Permit with site plan valid for sixty months. Authorization to Construct is valid for a period equal to that of Improvement Permit – not to exceed sixty months.

Signed: X [signature] date

Improvement Permit by: J.C. Moore date 5-12-98

Authorization to Construct by: J.C. Moore date 5-12-98

Installed by: Tommy Frye

Operation Permit by: Mgr COJRS date 3-12-99

Existing System Inspection by: date

HEALTH DEPT. COPY: WHITE INSPECTION COPY (FINAL): GREEN OWNER COPY (FINAL): YELLOW INSPECTION COPY (INITIAL): PINK OWNER COPY (INITIAL): GOLD