IREDELL COUNTY HEALTH DEPARTMENT

Statesville Office (704) 878-5305 Mooresville Office (704) 660-3625 PERMIT # 177620

IMPROVEMENT PERMIT / AUTHORIZATION TO CONSTRUCT / OPERATION PERMIT / EXISTING SYSTEM

PIN # 4757148885

APPLICANT: Maurice Cowan APPLICANT ADDRESS: 926 Hunter Bridge Rd. Stony Point

SITE ADDRESS: Bethany Rd PHONE: 704-799-5722 ALT. PHONE: 704-533-6163

SITE DIRECTIONS: 21 North, left on Bethany, Last vacant lot on left, before Pavement ends

SUBDIVISION: n/a SECTION: n/a LOT # n/a LOT AREA: .786 Ac DESIGN FLOW: 360 L.T.A.R.: .3

Septic Tank 1000 (gal) STB 760 Date 10-22-12

Pump Tank (gal) PT Date

Pump Make Model Serial #

Nitrification Fields 1 # Lines 3 Linear Ft: 300

Trench Width 36" Max. Trench Bottom Depth 36" Gravel Depth n/a

☒ New System ☐ Repair ☐ Expansion System Type: I II (III) IV V VI

System Description: 25% Reduction - Gravity

Repair System Description: 25% Reduction - Gravity

Maintenance Agreement Required: ☐ YES ☒ NO

☒ GRAVITY ☐ PRESSURE

☒ Residence ☐ Business ☐ Other ☐ Slab ☒ Crawl Space ☐ Basement w/ plumbing


No. Bedrooms 3 No. Persons No. Employees

Water Supply: ☐ Private ☒ Public ☐ Community


☐ Basement w/o plumbing

Comments / Conditions:

INITIAL SITE SKETCH

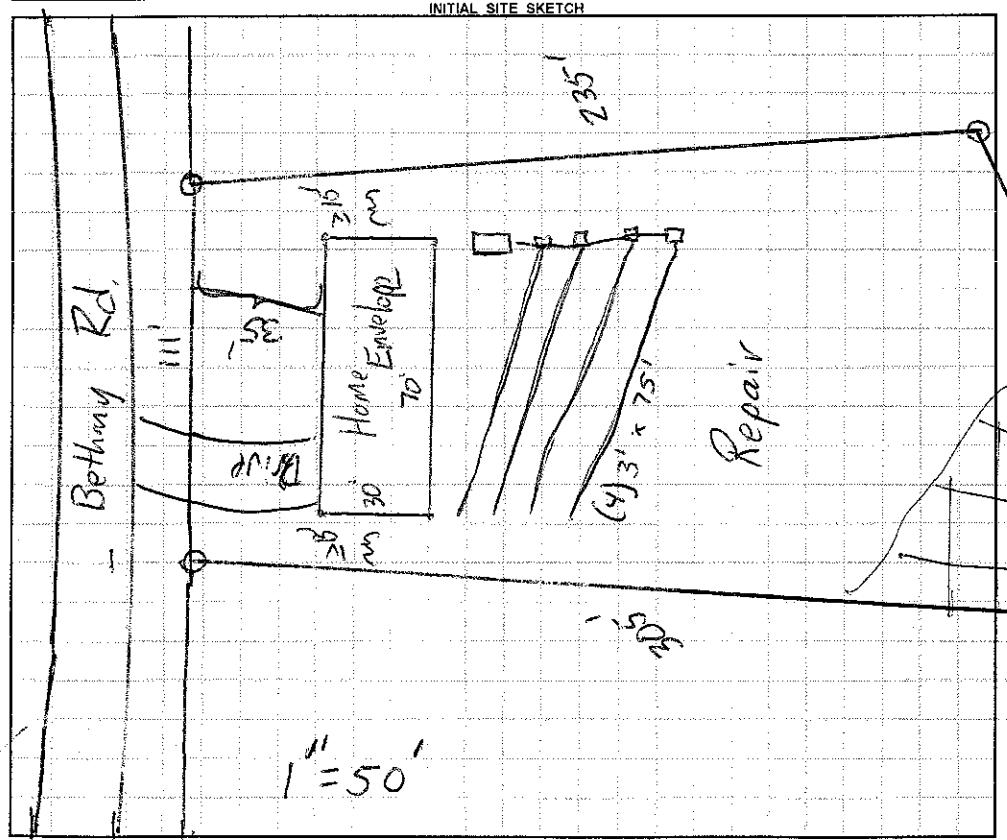

AS BUILT SKETCH

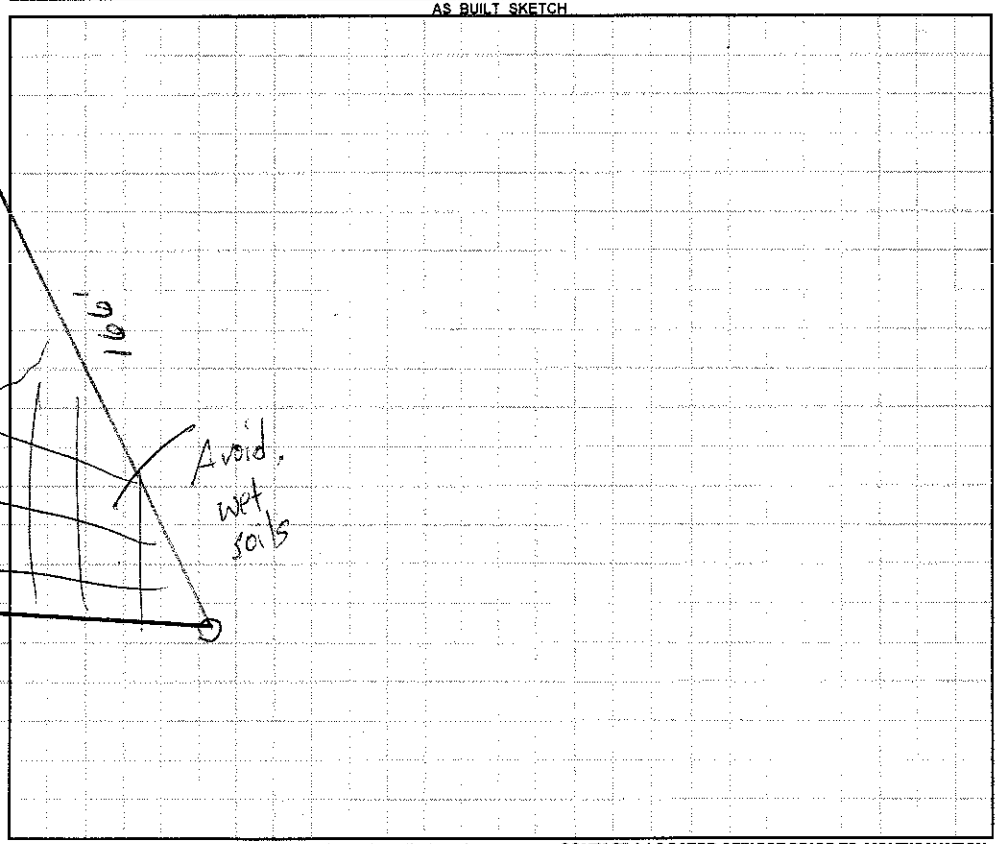

Permit can be suspended or revoked if any false information is supplied toward securing the permit / any unauthorized changes are made to the site / any unauthorized changes are made in the installation of the system. **CONTACT A LOCATOR SERVICE PRIOR TO ANY EXCAVATION**

☐ **IMPROVEMENT PERMIT *with plat*** *valid without expiration.* ☒ **IMPROVEMENT PERMIT *with site plan*** *valid for 60 mos.* ☒ **AUTHORIZATION TO CONSTRUCT** *valid for period equal to IMPROVEMENT PERMIT--not to exceed 60 mo.*

Owner / Applicant Signature: Robyn Cowan Date: 4-9-13 Installed by: A-1 Backhoe

IMPROVEMENT PERMIT by: James Date: 4-5-13 OPERATION PERMIT by: James Date: 4-16-13

AUTHORIZATION TO CONSTRUCT by: James Date: 4-5-13 Existing System Inspected by: Date:

Health Dept. Copy - WHITE Applicant (Final Approval) - YELLOW Applicant (Conditional Approval) - PINK