IREDELL COUNTY HEALTH DEPARTMENT

STATESVILLE 704-878-5305 MOORESVILLE 704-664-5281

IMPROVEMENT PERMIT / AUTHORIZATION TO CONSTRUCT / OPERATION PERMIT / EXISTING SYSTEM INSPECTION

PERMIT# REPAIR PIN# 4757-14-8917 DATE 7-7-08

OWNER OR APPLICANT GLENN S. MILLSAPS PHONE: Business 704-657-4387 Home 704-876-4381

ADDRESS 213 BETHANY ROAD, STATESVILLE, NC 28625-2701

LOCATION US 21 NORTH, TR | BETHANY ROAD AT END ON LEFT AT BOX # 213

SUBDIVISION _____ BLOCK / SECTION _____ LOT 1 LOT AREA 0.5 ACRE SITE CLASS. PS DESIGN FLOW 480 L.T.A.R. EXISTING

Septic Tank: 1000 Gallons: STB 760 Date 4-16-08

Pump Tank: _____ Gallons: PT _____ Date _____

Pump Make: _____ Model _____ Serial No. _____

Nitrification Field: No Fields 1 Square Feet EX Linear Feet EXISTING

No Lines EXISTING ~~Trench~~ Width EX Max Trench Bottom Depth EX Gravel Depth EX

☐ New System ☑ Repair ☐ Expansion System Type: I (II) III IV V VI

System Description: _____

Repair System Description: CONVENTIONAL, GRAVITY

Maintenance Agreement Required: ☐ Yes ☒ No

☐ ~~House~~/Mod. Home No. Bedrooms 4

☐ Mobile Home No. Persons ____

☐ Business No. Employees ____

☐ Other _____


☑ Gravity ☐ Pressure ☐ Slab ☒ Crawl Space ☐ Basement w/plumbing ☐ Basement wo/plumbing

Water Supply: ☐ Individual ☒ Public ☐ Community

Comments/Conditions: PUMP OUT & EXCAVATE EXISTING SEPTIC TANK, REPLACE WITH NEW SEPTIC TANK IN SAME LOCATION AS SHOWN.

Comments/Conditions: SEPTIC TANK WITH RISERS AND RED POLYLOK FILTER INSTALLED.

INITIAL SITE SKETCH ~SCALE: 1"=40'

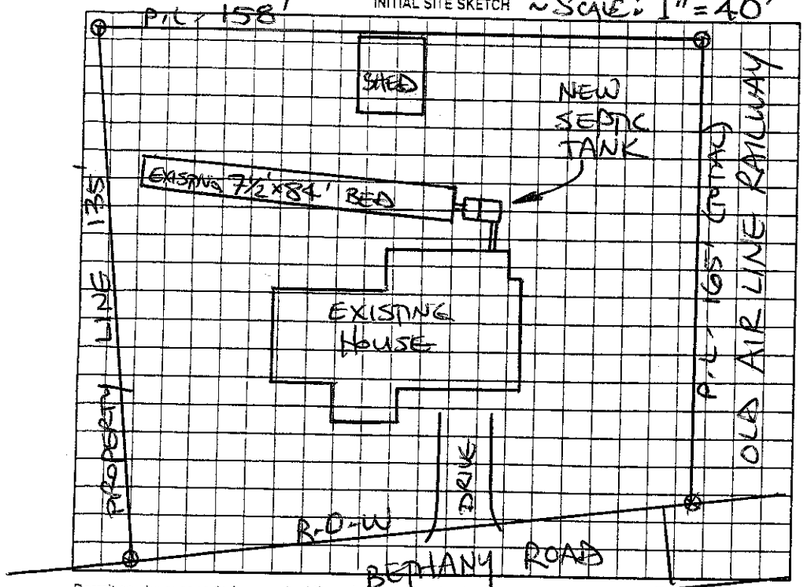

AS BUILT SKETCH

SYSTEM REPAIRED ACCORDING TO INITIAL SITE SKETCH

Permit can be suspended or revoked if any false information is supplied toward securing the permit/any unauthorized changes are made to the site/any unauthorized changes are made in the installation of the system. Improvement Permit with plat valid without expiration ☐ Improvement Permit with site plan valid for sixty months ☒ Authorization to Construct is valid for a period equal to that of Improvement Permit – not to exceed sixty months.

Signed: x Kathy Millsaps date 7-7-08

Improvement Permit by: STEVE HEDRICK date 7-7-08

Authorization to Construct by: STEVE HEDRICK date 7-7-08

Installed by: A-1 BACKHOE

Operation Permit by: STEVE HEDRICK date 7-22-08

Existing System Inspection by: _____ date _____

HEALTH DEPT. COPY: WHITE OWNER COPY (FINAL): YELLOW OWNER COPY (INITIAL): PINK