IREDELL COUNTY HEALTH DEPARTMENT

Statesville Office (704) 878-5305 Mooresville Office (704) 660-3625 PERMIT # 214575

IMPROVEMENT PERMIT / AUTHORIZATION TO CONSTRUCT / OPERATION PERMIT / EXISTING SYSTEM

PIN # 4757170319

APPLICANT: John Eckman APPLICANT ADDRESS: 269 Reeves Rd.

SITE ADDRESS: 269 Reeves Rd. PHONE: 704-876-1160 ALT. PHONE: N/A

SITE DIRECTIONS: Hwy 21 N TL Jennings Rd TR Reeves Rd.

SUBDIVISION: N/A SECTION: N/A LOT # N/A LOT AREA: 2.0 acres DESIGN FLOW: 360gpd L.T.A.R.: Existing

Septic Tank	Ex (gal)	STB	Date		
Pump Tank	(gal)	PT	Date		
Pump Make		Model	Serial #		
# Nitrification Fields	Ex	# Lines Ex	Linear Ft: Ex		
Trench Width	Ex	Max. Trench Bottom Depth Ex	Gravel Depth Ex		

☐ New System ☐ Repair ☐ Expansion System Type: I II III IV V VI

System Description: Existing

Repair System Description:

Maintenance Agreement Required: ☐ YES ☑ NO

☑ GRAVITY ☐ PRESSURE

☑ Residence No. Bedrooms 3

☐ Business No. Persons 6

☐ Other No. Employees

☐ Slab ☐ Crawl Space


☑ Basement w/plumbing ☐ Basement w/o plumbing

Water Supply: ☑ Private ☐ Public ☐ Community


Comments / Conditions:

- Maintain a minimum of 5' between proposed acc. bldg foundation & all components of septic tank system.

INITIAL SITE SKETCH

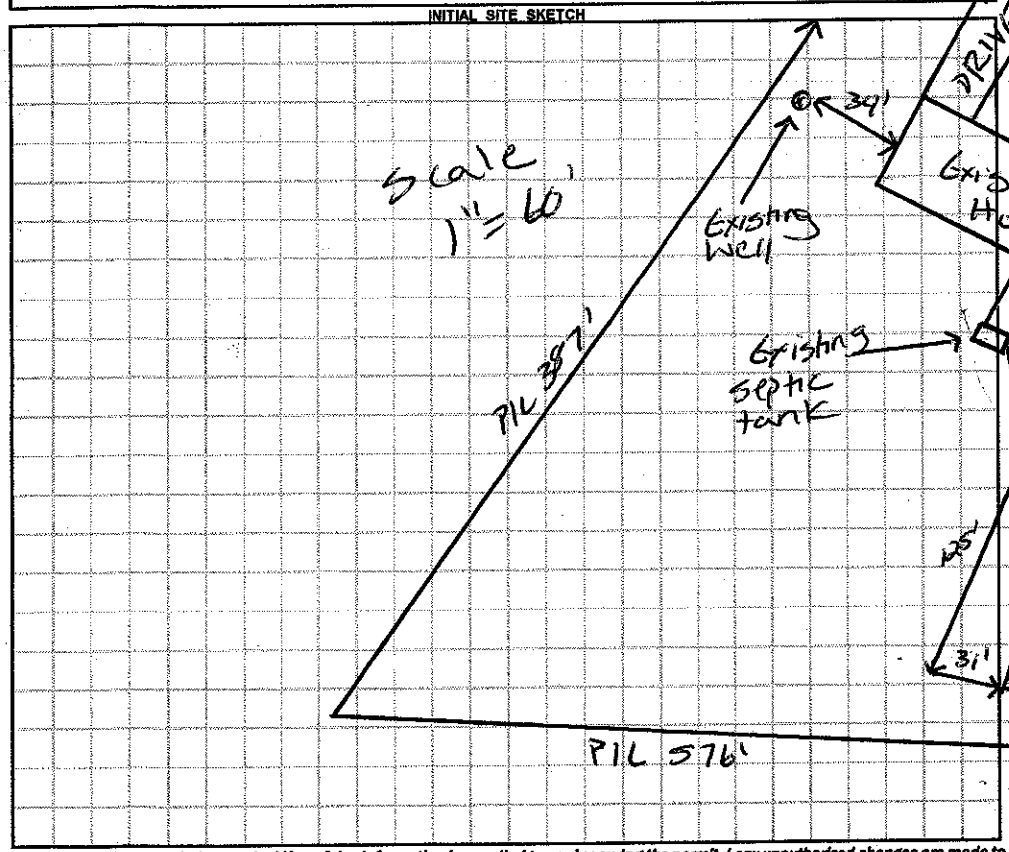

AS BUILT SKETCH

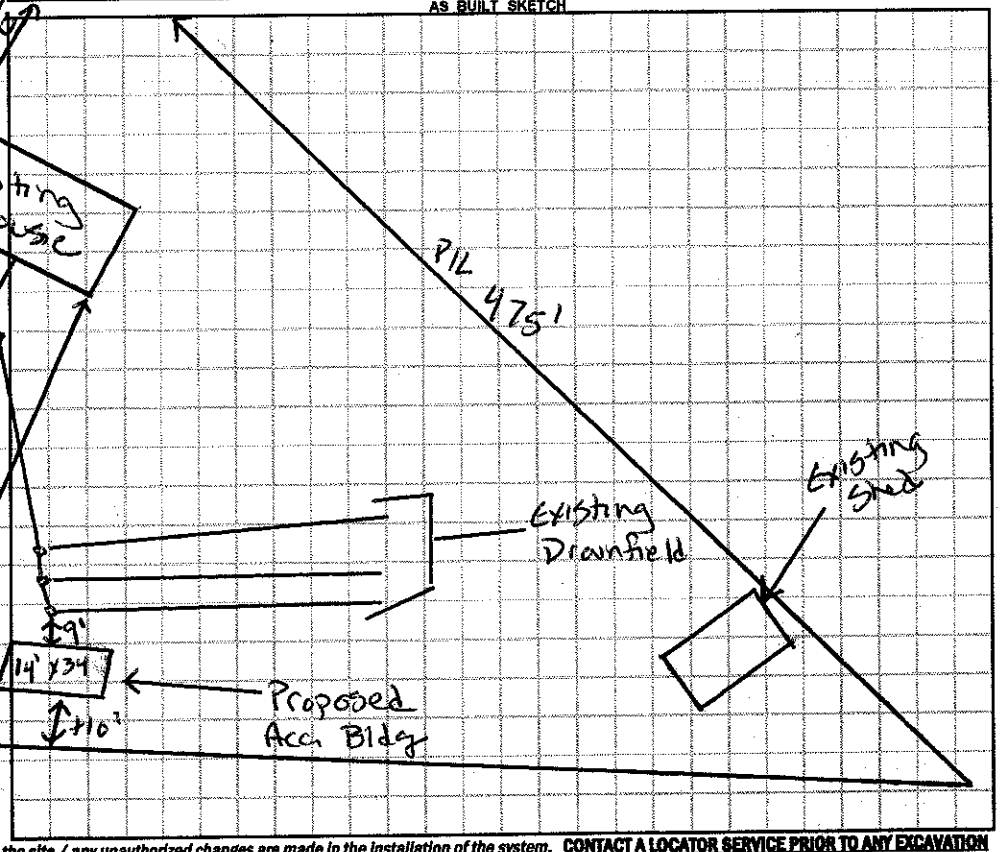

Permit can be suspended or revoked if any false information is supplied toward securing the permit / any unauthorized changes are made to the site / any unauthorized changes are made in the installation of the system. **CONTACT A LOCATOR SERVICE PRIOR TO ANY EXCAVATION**


☐ **IMPROVEMENT PERMIT** *with plan valid without expiration.* ☐ **IMPROVEMENT PERMIT** *with site plan valid for 60 mos.* ☐ **AUTHORIZATION TO CONSTRUCT** *valid for period equal to IMPROVEMENT PERMIT--not to exceed 60 mo.*

Owner / Applicant Signature: John P. Eckman Date: 12-3-15 Installed by:

IMPROVEMENT PERMIT by: Date: OPERATION PERMIT by: Date:

AUTHORIZATION TO CONSTRUCT by: Date: Existing System Inspected by: Justin Henderson Date: 12-3-15

Health Dept. Copy - WHITE Applicant (Final Approval) - YELLOW Applicant (Conditional Approval) - PINK

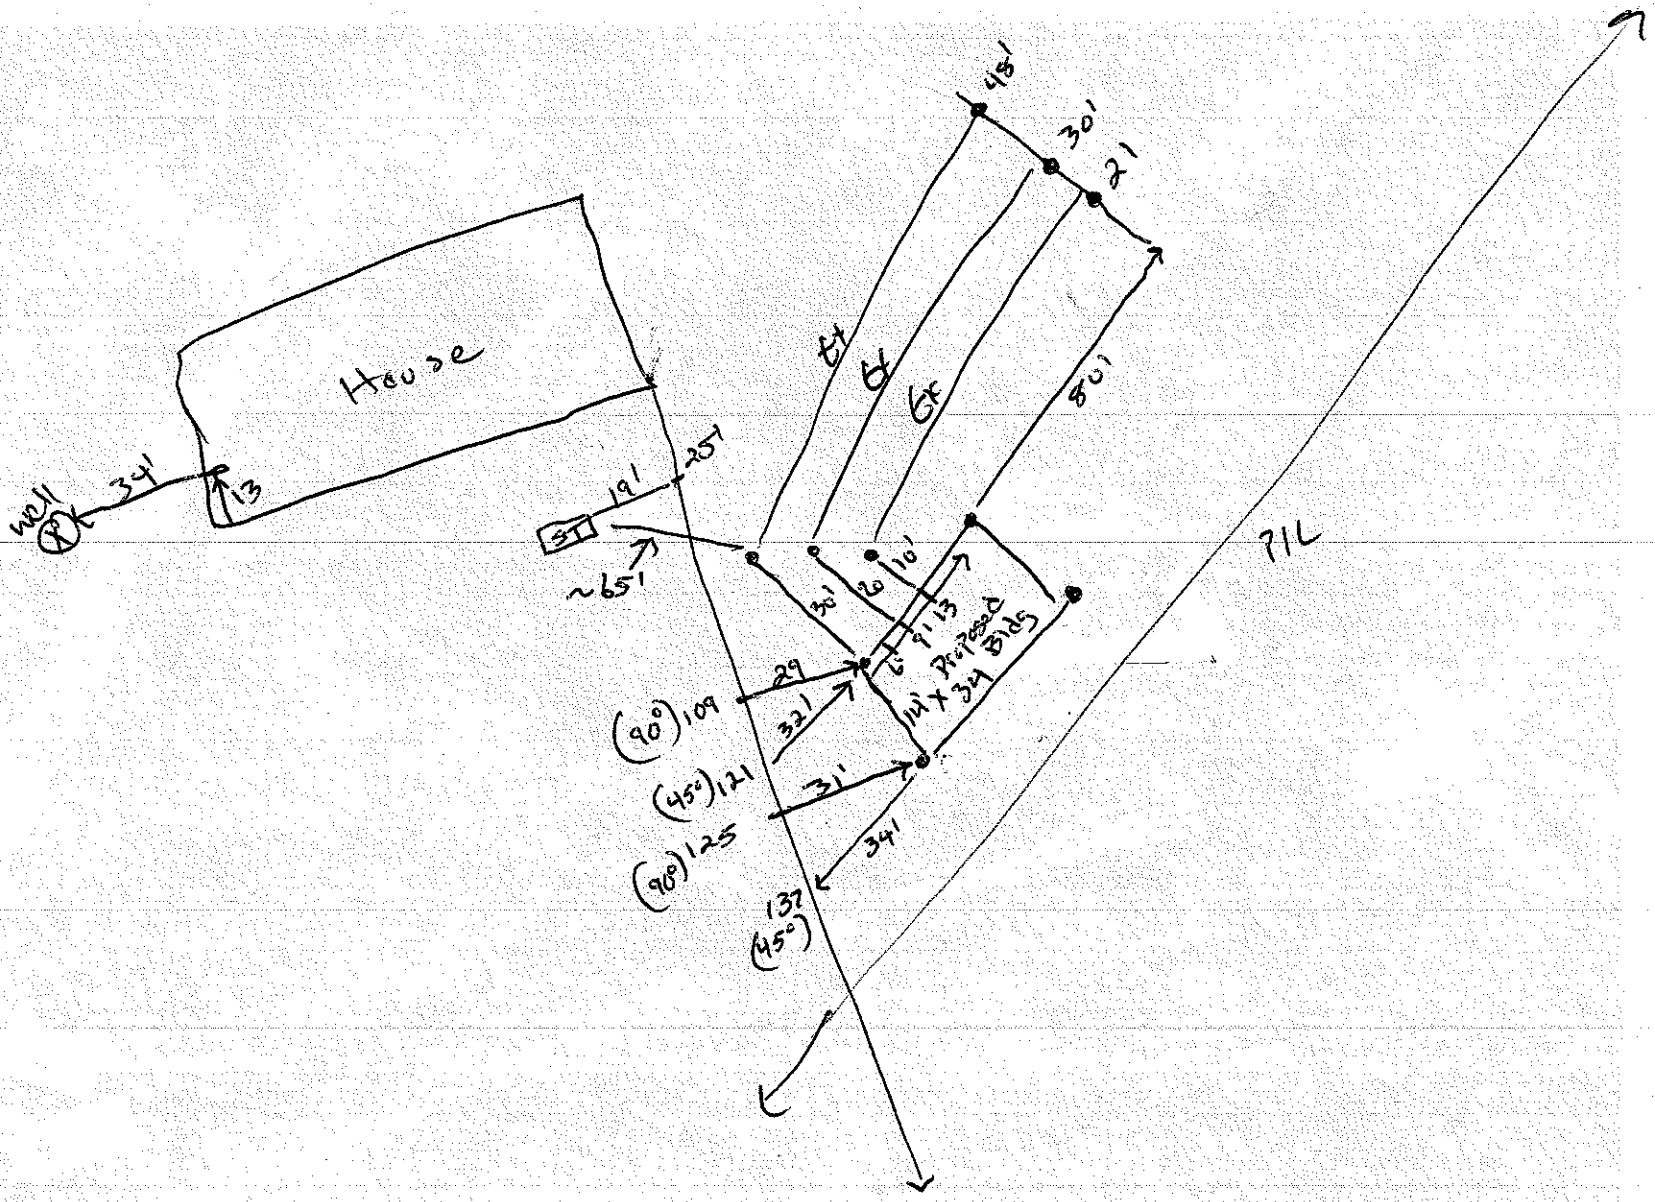
House
well
34'
13
19'
25'
ST
~65'
48'
30'
21'
64'
64'
64'
50'
30'
20
10'
Proposed
14' x 34' Bldg
29
32'
31'
34'
(90°) 109
(45°) 121
(90°) 125
137
(45°)
PIL