1.00

IREDELL COUNTY HEALTH DEPARTMENT

STATESVILLE 704-878-5305 MOORESVILLE 704-664-5281

IMPROVEMENT PERMIT / CERTIFICATE OF COMPLETION / OPERATION PERMIT / EXISTING SYSTEM INSPECTION

PROPERTY DESCRIPTION NO. _____ DATE 12-4-95 TAX MAP NO. _____ Watershed: ☐ Yes ☐ No

OWNER OR CONTRACTOR John Eckman PHONE: Business _____ Home 876-1160

ADDRESS 249 Reeves Rd

LOCATION 21N TL Jennings TR Reeves attend on left

SUBDIVISION _____ BLOCK / SECTION _____ LOT _____ LOT AREA 2 acres SITE CLASS PS DESIGN FLOW 360 L.T.A.R. 14

Septic Tank: Ex. Gallons; STB _____ Date _____

Pump Tank: _____ Gallons; PT _____ Date _____

Pump Make: _____ Model _____ Serial No. _____

Nitrification Field: No Fields 1 Square Feet 900 Linear Feet 300

No Lines _____ Trench Width _____ Max Trench Bottom Depth _____ Gravel Depth _____

☐ New System ☑ Repair System Type: I II III, IV, V, VI

System Description: _____

Repair System Description: Conv. Capacity

Maintenance Agreement Required: ☐ Yes ☐ No

☑ House/Mod. Home No. Bedrooms 3

☐ Mobile Home No. Bathrooms 2

☐ Business No. Employees ____

☐ Other _____


☐ Slab ☐ Crawl Space ☐ Basement w/plumbing ☐ Basement wo/plumbing

Water Supply:
☑ Individual
☐ Community
☐ Public

Comments:

Comments:

INITIAL SITE SKETCH

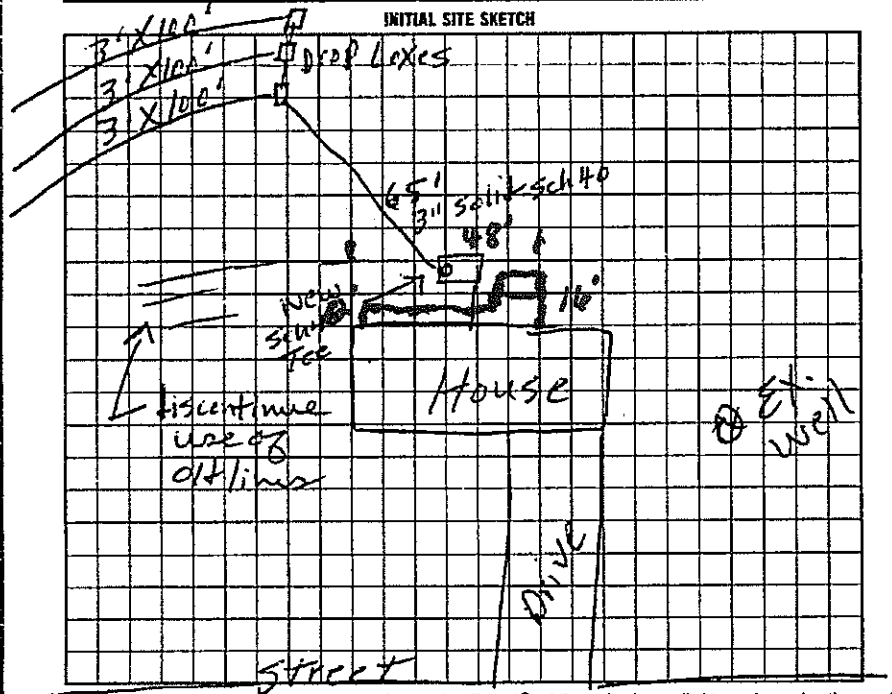

AS BUILT SKETCH

Same as initial sketch

Location of the proposed deck addition does not appear to impact the existing on-site septic system.**NOTE: _____

_____ REHS

Date: 7-15-71

ICHD-Environmental Health Division

I understand that this permit can be suspended or revoked if any false information is supplied toward securing the permit/any unauthorized changes are made to the site/any unauthorized changes are made in the installation of the system.

Signed: x John P. Eckman

Installed by: James Hutler

Improvement Permit by: C. Moore date 12-4-95

Authorization to Const

Existing System Inspection by: C. Moore date 12-4-95

Certificate of Completion by: _____ date _____

Operation Permit by: C. Moore date 4-16-96

HEALTH DEPT. COPY: WHITE INSPECTION COPY (FINAL): GREEN OWNER COPY (FINAL): YELLOW INSPECTION COPY (INITIAL): PINK OWNER COPY (INITIAL): GOLD

Authorization to Const EXPIRES 60 MOS Stamp to issue

S 1 0 0 0 0