IREDELL COUNTY HEALTH DEPARTMENT

STATESVILLE 704-878-5305 MOORESVILLE 704-664-5281

IMPROVEMENT PERMIT / CERTIFICATE OF COMPLETION / OPERATION PERMIT / EXISTING SYSTEM INSPECTION

PROPERTY DESCRIPTION NO. NC Dept of Transportation DATE 12-16-93 TAX MAP NO. Watershed: ☐ Yes ☒ No

OWNER OR CONTRACTOR Turnersburg District office PHONE: Business 704-876-3947 Home

ADDRESS

LOCATION Hwy 21 N Just Past I-77 on Rt.

SUBDIVISION BLOCK / SECTION LOT LOT AREA SITE CLASS. PS DESIGN FLOW 500 L.T.A.R. .3 gal/ft²/day

Septic Tank: EX Gallons; STB Date

Pump Tank: Gallons; PT Date

Pump Make: Model Serial No.

Nitrification Field: No Fields 2 Square Feet 1890 Linear Feet 640

No Lines 5 Trench Width 36" Max Trench Bottom Depth 24" Gravel Depth 12"

☐ New System ☐ Repair System Type: I, II, (III), IV, V, VI

System Description:

Repair System Description: Conv. Gravity

Maintenance Agreement Required: ☐ Yes ☒ No

☐ House/Mod. Home ☐ Mobile Home ☐ Business ☐ Other

No. Bedrooms No. Bathrooms No. Employees 20


☐ Slab ☐ Crawl Space ☐ Basement w/plumbing ☐ Basement wo/plumbing

Water Supply: ☐ Individual ☐ Community ☒ Public

Comments: Remove roots mat from Head of Existing field + replace with gravel Replace Sanitary Tee In Septic Tank with Sch 40 Tee

Comments: * CHECK PLUMBING TO ELIMINATE LEAKS

INITIAL SITE SKETCH

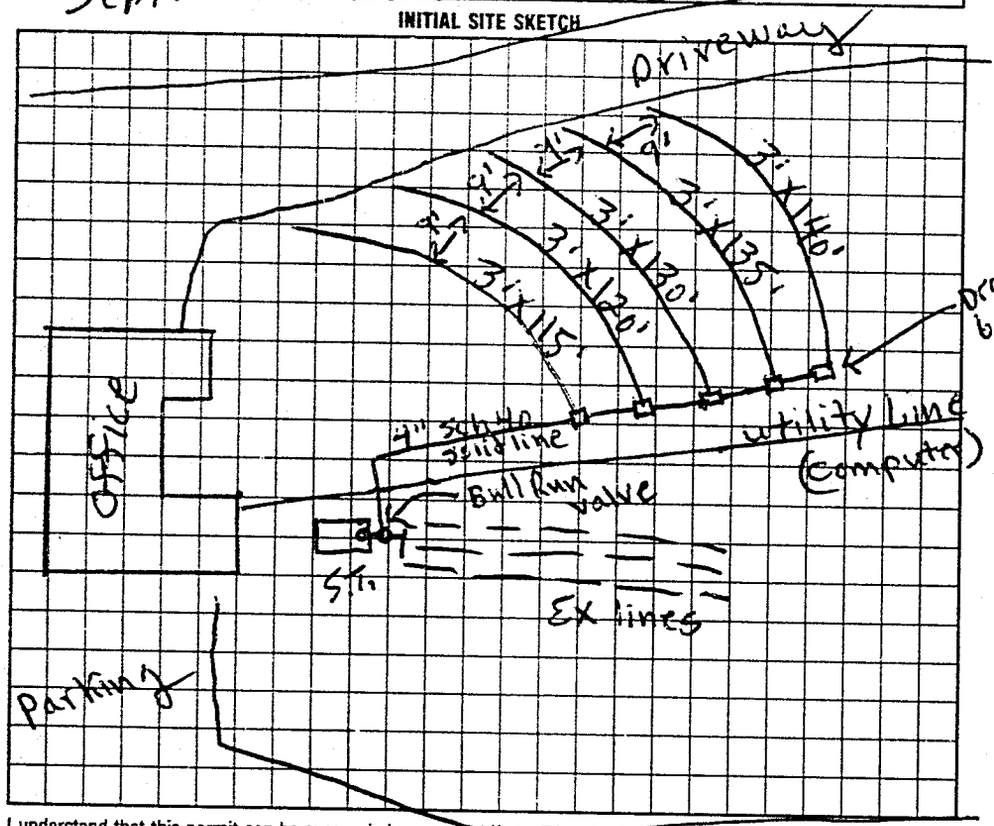

AS BUILT SKETCH

SYSTEM INSTALLED ACCORDING TO INITIAL SITE SKETCH

CHECK PLUMBING TO ELIMINATE LEAKS

I understand that this permit can be suspended or revoked if any false information is supplied toward securing the permit/any unauthorized changes are made to the site/any unauthorized changes are made in the installation of the system. Improvement Permit is valid for 60 months from date of issuance.

Signed: X James W Pond

Improvement Permit by: R. C. Moore date 12-16-93

Existing System Inspection by: date

Installed by: Sammy Reavis

Certificate of Completion by: Steve Hedrick date 2/16/94

Operation Permit by: date

HEALTH DEPT. COPY: WHITE INSPECTION COPY (FINAL): GREEN OWNER COPY (FINAL): YELLOW INSPECTION COPY (INITIAL): PINK OWNER COPY (INITIAL): GOLD