IREDELL COUNTY HEALTH DEPARTMENT

STATESVILLE 704-878-5305 (D) MOORESVILLE 704-664-5281 (@)

IMPROVEMENT PERMIT / AUTHORIZATION TO CONSTRUCT / OPERATION PERMIT / EXISTING SYSTEM INSPECTION

PERMIT# 115405 PIN# 4757 20 1334.5 DATE 9/3/03

OWNER OR CONTRACTOR IREDELL COUNTY PHONE: Business 878-3054 Home

ADDRESS PO BOX 788 STATESVILLE NC 28687

LOCATION 21 NORTH - TR PRISON CAMP RD - BEHIND PRISON

SUBDIVISION — BLOCK / SECTION — LOT LOT AREA 110.19AC SITE CLASS. RS DESIGN FLOW 1620 L.T.A.R. .30/FT2

Septic Tank: @ 3000 Gallons; STB Date

Pump Tank: 3000 Gallons; PT Date

Pump Make: WEOI72H Model GOULDS Serial No.

Nitrification Field: No Fields 2 Square Feet 5400 Linear Feet 1800

No Lines 12 @ 150' Trench Width 36" Max Trench Bottom Depth 36" Gravel Depth 12"

☑ New System ☐ Repair System Type: I, II, III, IV, V, VI

System Description: PUMP CONVENTIONAL

Repair System Description: SAME

Maintenance Agreement Required: ☐ Yes ☑ No

☐ House/Mod. Home No. Bedrooms

☐ Mobile Home No. Bathrooms

☐ Business No. Employees

☑ Other PRISON

☑ Slab ☐ Crawl Space ☐ Basement w/plumbing ☐ Basement wo/plumbing

Water Supply: ☐ Individual ☒ Public ☐ Community


Comments:/Conditions:

Comments:/Conditions: 4 28 SINGLE CELLS
24 - DORMATORY LIVEING
NO FOOD PREPARATION

INITIAL SITE SKETCH 1"=60'



AS BUILT SKETCH

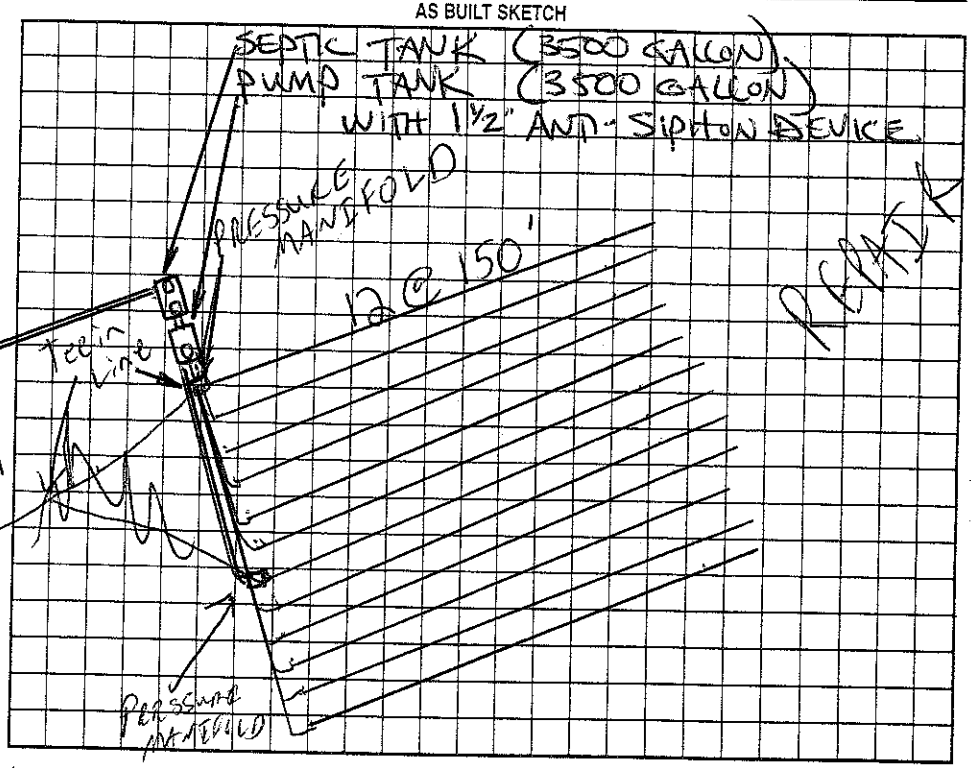

Permit can be suspended or revoked if any false information is supplied toward securing the permit/any unauthorized changes are made to the site/any unauthorized changes are made in the installation of the system. Improvement Permit with plat valid without expiration. Improvement Permit with site plan valid for sixty months. Authorization to Construct is valid for a period equal to that of Improvement Permit – not to exceed sixty months.

Signed: date 9-4-03

Improvement Permit by: C. Yoder RS date 9/3/03

Authorization to Construct by: C. Yoder RS date 9/3/03

Installed by: INITIAL - UNKNOWN / REPAIR - JARED LENTZ

Operation Permit by: STEVE HENDRICK date 11/18/2011

Existing System Inspection by: date

HEALTH DEPT. COPY: WHITE OWNER COPY (FINAL): YELLOW OWNER COPY (INITIAL): PINK