IREDELL COUNTY HEALTH DEPARTMENT

Statesville Phone TR 3-7271 Mooresville Phone NO 3-1271

PERMIT TO INSTALL SEPTIC TANK

Permit NO. 257 Permit Date _____ 19__

Owner State Highway Commission Address Raleigh, N.C.

Installed By L.R. Troutman Address Hickory, N.C.


Location of Property North on #21 to the N.C. Prison Dept.; Iredell County Division Camp. New State Highway Offices

Tank		Capacity		Length of Lines		Fixtures	
Block	( )	1000	(✓)	225'	( )	No. of Baths	(2)
Precast	(✓)	1250	( )	250'	( )	Dishwasher	( )
		1500	( )	Other ~~250'~~		Garbage Grdr.	( )
		Other _____				Other _____	

NOTIFY HEALTH DEPARTMENT AT LEAST EIGHT HOURS BEFORE TANK IS TO BE INSPECTED.

Final Inspection July 31 19 70 Approved (✓) Disapproved ( )

Remarks _____

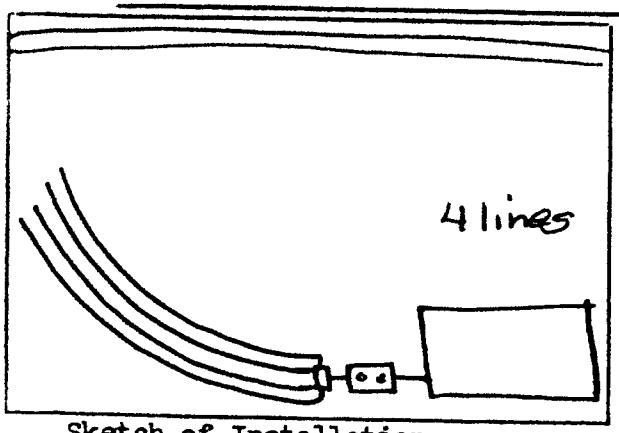

Sketch of Installation

Cress S. Hall

Sanitarian