IREDELL COUNTY HEALTH DEPARTMENT

STATESVILLE 704-878-5305 (C1) MOORESVILLE 704-664-5281

IMPROVEMENT PERMIT / AUTHORIZATION TO CONSTRUCT / OPERATION PERMIT / EXISTING SYSTEM INSPECTION

PERMIT# 112180 PIN# 4757-21-~~5771~~ 3798 DATE 05-21-03

OWNER OR CONTRACTOR MARTY MALTBY PHONE: Business 704-902-3907 Home

ADDRESS 3624 GORDON ST TERRELL NC 28682

LOCATION 21 NORTH ON RT PAST PRISON CAMP RD & BESIDE KENTS TRUCK COVERS

SUBDIVISION BLOCK / SECTION LOT LOT AREA 2.84 AC SITE CLASS PS DESIGN FLOW 700 L.T.A.R. .3

Septic Tank: 1500 Gallons; STB 1011 Date 10-6-03
Pump Tank: Gallons; PT Date
Pump Make Model Serial No.
Nitrification Field: No Fields 1 Square Feet 60x233.4 Linear Feet 590'
No Lines 6 Trench Width 36" Max Trench Bottom Depth 36"

☒ New System ☐ Repair System Type: I, II, (III), IV, V, VI
System Description: GRAV 25% REDUCTION
Repair System Description: LP PANEL
Maintenance Agreement Required: ☐ Yes ☒ No


☐ House/Mod. Home No. Bedrooms
☐ Mobile Home No. Bathrooms
☐ Business No. Employees
☒ Other 7 OFFICE UNITS

Water Supply: ☐ Individual ☒ Public ☐ Community

Gravel Depth N/A ☒ Slab ☐ Crawl Space ☐ Basement w/plumbing ☐ Basement wo/plumbing

Comments/Conditions:

INITIAL SITE SKETCH

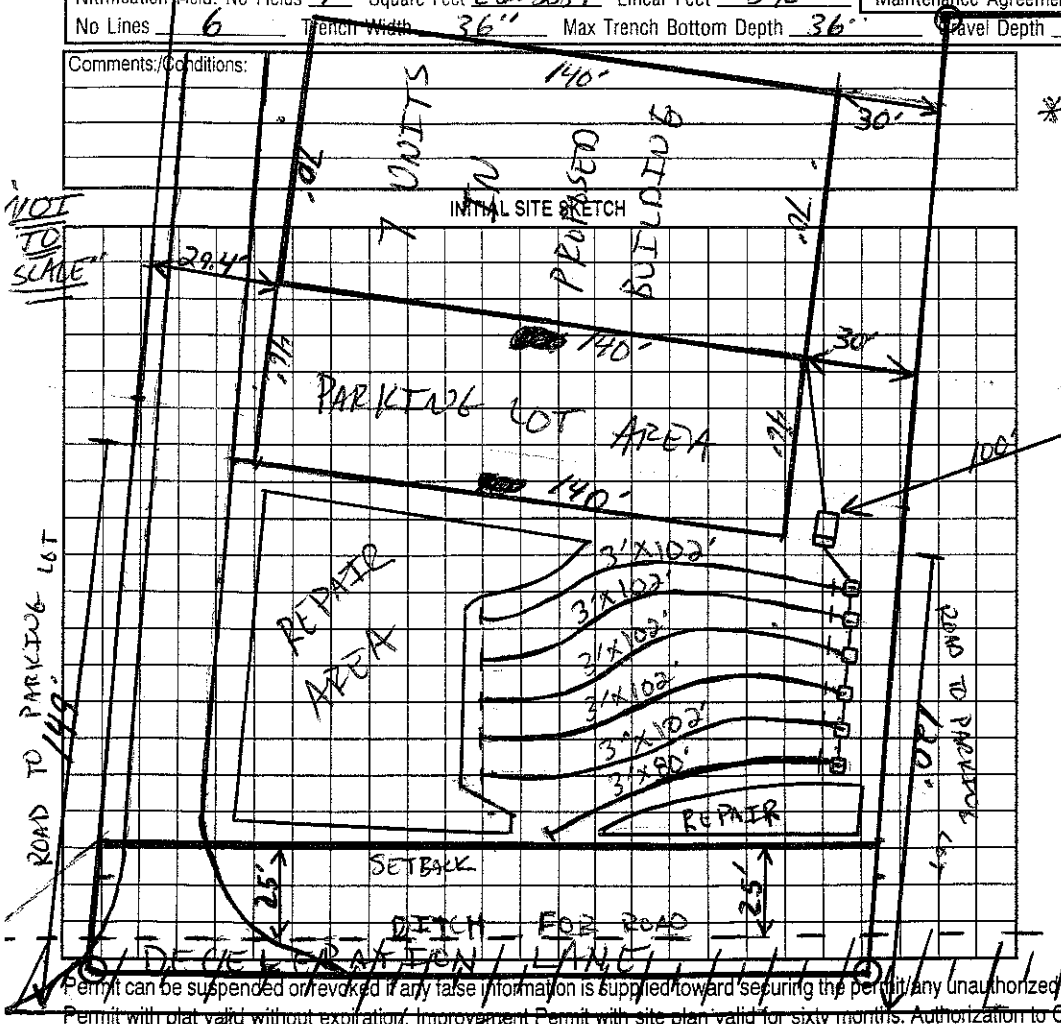


Comments/Conditions:

(1) SYSTEM IS FLAGGED OUT COMPLETELY.

* (2) INSTALL CONSTRUCTION BARRIOR FENCE AROUND SYSTEM AREA TO PROTECT FLAGS & UNNECESSARY VEHICULAR TRAFFIC.

(3) MAINTAIN SETBACKS & INSTALL LINES ON CONTOURS (4) STRINGED LINE ON LOT IS SHOWN AS BUILT SKETCH WHERE PARKING LOT LINE IS.

AS BUILT SKETCH

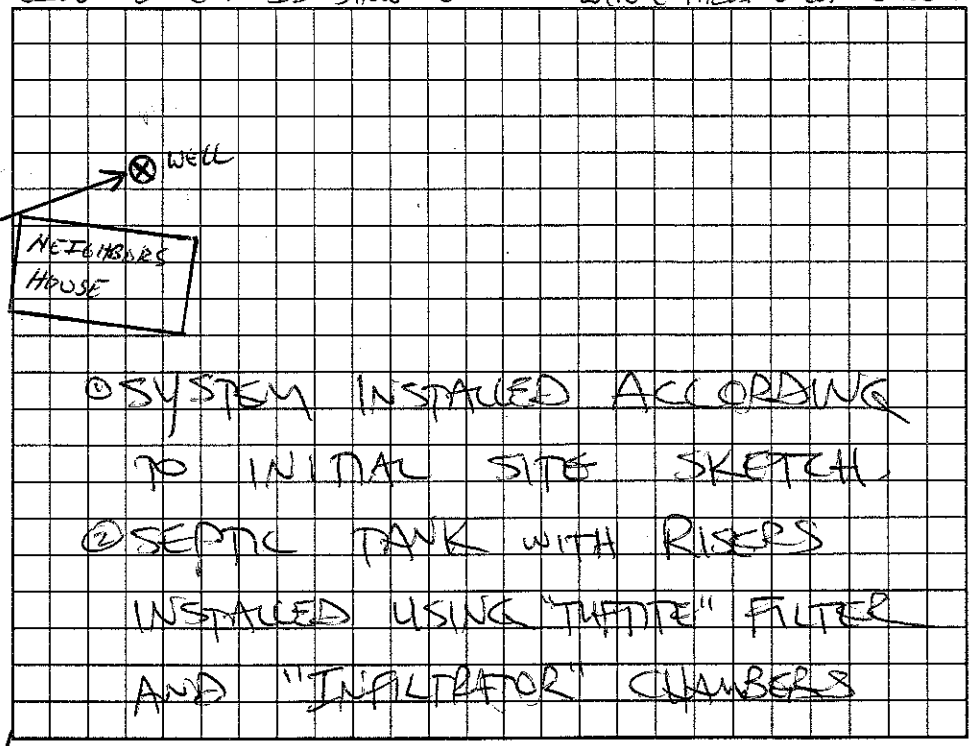

(5) SYSTEM INSTALLED ACCORDING TO INITIAL SITE SKETCH

(2) SEPTIC TANK WITH RISERS INSTALLED USING "THETITE" FILTER AND "INFILTRATOR" CHAMBERS

Permit can be suspended or revoked if any false information is supplied toward securing the permit/any unauthorized changes are made to the site/any unauthorized changes are made in the installation of the system. Improvement Permit with plat valid without expiration. Improvement Permit with site plan valid for sixty months. Authorization to Construct is valid for a period equal to that of Improvement Permit – not to exceed sixty months.

Signed: date 7-24-03 Installed by: TOMMY FRYE

Improvement Permit by: date 05-21-03 Operation Permit by: STEVE HENDRICK date 11-12-03

Authorization to Construct by: date 05-21-03 Existing System Inspection by: date

HEALTH DEPT. COPY: WHITE OWNER COPY (FINAL): YELLOW OWNER COPY (INITIAL): PINK