IREDELL COUNTY HEALTH DEPARTMENT

Statesville Office (704) 878-5305 Mooresville Office (704) 660-3625 PERMIT # 200957 IRP

IMPROVEMENT PERMIT / AUTHORIZATION TO CONSTRUCT / OPERATION PERMIT / EXISTING SYSTEM

PIN # 4757224405

APPLICANT: Mike Chambers APPLICANT ADDRESS: 1115 Turnersburg Hwy.

SITE ADDRESS: 1117 Turnersburg Hwy PHONE: 704-883-4696 ALT. PHONE: N/A

SITE DIRECTIONS: Hwy 21 N, Property on Left ~ 2/10 miles past Prison Camp Rd.


SUBDIVISION: Bowden & Murray SECTION: N/A LOT # 20 + PT21 LOT AREA: 0.34 acres DESIGN FLOW: 480 gpd L.T.A.R.: 0.3

Septic Tank	Existing (gal)	STB		Date		☐ New System	☑ Repair	☐ Expansion	System Type: I II III IV V VI	☑ Residence	No. Bedrooms 4
Pump Tank	(gal)	PT		Date		System Description:				☐ Business	No. Persons 8
Pump Make		Model		Serial #		Repair System Description: 50% Reduction - PPBPS				☐ Other	No. Employees
# Nitrification Fields	1	# Lines	4	Linear Ft:	160	Maintenance Agreement Required:	☐ YES	☑ NO		☐ Slab	☐ Crawl Space
Trench Width	24"	Max. Trench Bottom Depth	36"	Gravel Depth	N/A		☑ GRAVITY	☐ PRESSURE		☑ Basement w/plumbing	☐ Basement w/o plumbing


Water Supply: ☐ Private ☐ Public ☑ Community

Comments / Conditions: Install a PPBPS system on contours with parallel distribution, utilizing an effluent splitter such as Zoellar. Supply line shall be constructed of ductile iron or equivalent under drive area unless 30" cover can be maintained. Install a Bull-run valve at location shown below & connect new drainfield to existing as shown. Replace septic tank if needed.

INITIAL SITE SKETCH

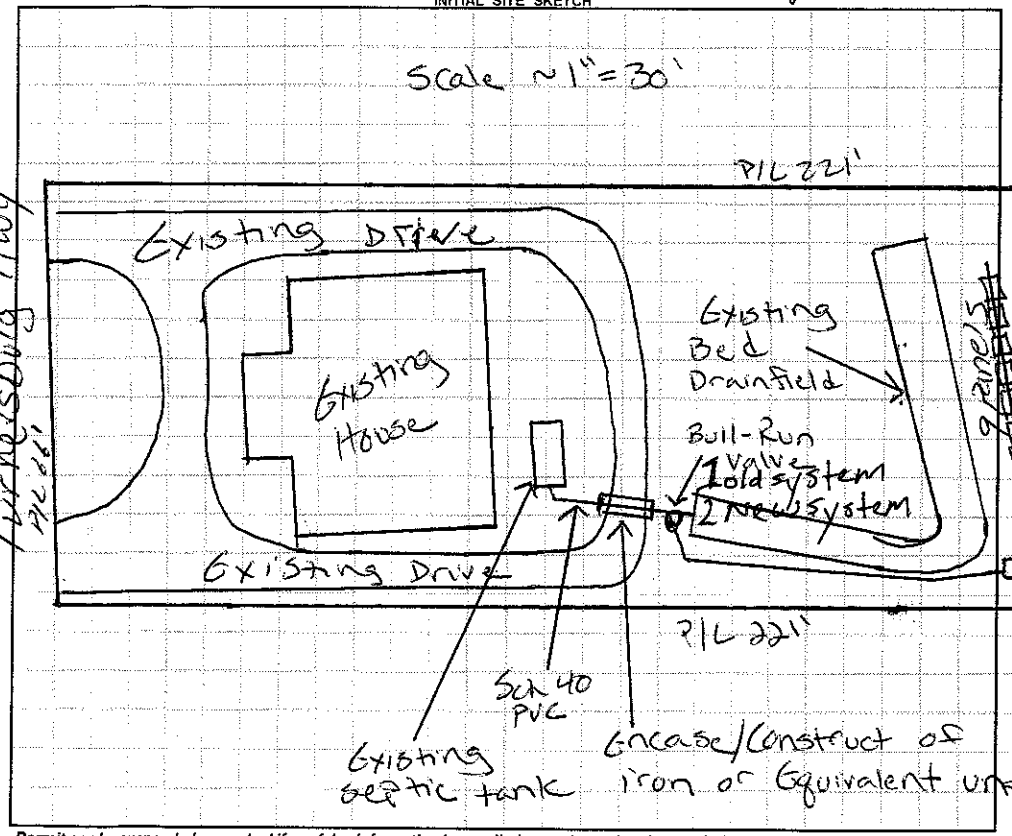

AS BUILT SKETCH

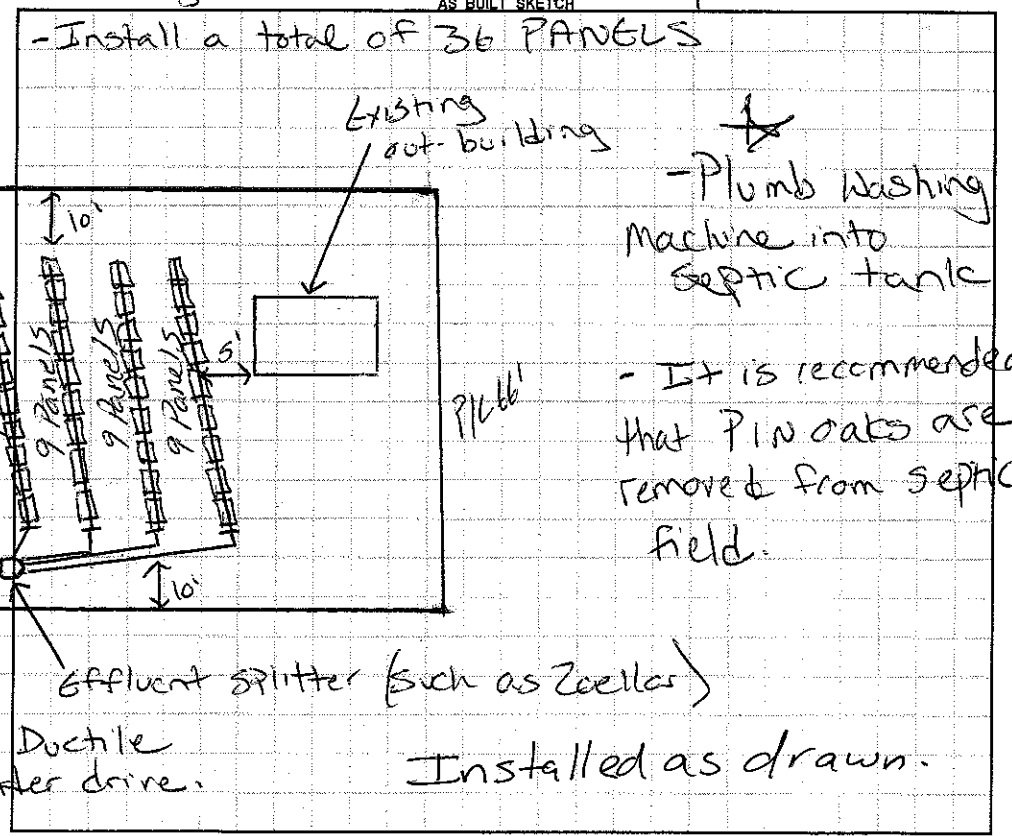

Permit can be suspended or revoked if any false information is supplied toward securing the permit / any unauthorized changes are made to the site / any unauthorized changes are made in the installation of the system. **CONTACT A LOCATOR SERVICE PRIOR TO ANY EXCAVATION**

☐ **IMPROVEMENT PERMIT** *with plat* valid without expiration. ☑ **IMPROVEMENT PERMIT** *with site plan* valid for 60 mos. ☑ **AUTHORIZATION TO CONSTRUCT** valid for period equal to IMPROVEMENT PERMIT--not to exceed 60 mo.

Owner / Applicant Signature: Mike Chambers Date: 1-16-14 Installed by: Steve Jordan

IMPROVEMENT PERMIT by: Justin Henderson Date: 1-16-14 OPERATION PERMIT by: Robert H. Shaw Date: 5-1-14

AUTHORIZATION TO CONSTRUCT by: Justin Henderson Date: 1-16-14 Existing System Inspected by: Date:

Health Dept. Copy - WHITE Applicant (Final Approval) - YELLOW Applicant (Conditional Approval) - PINK