IREDELL COUNTY HEALTH DEPARTMENT

Statesville Phone TR 3-7271 Mooresville Phone NO 3-1271

PERMIT TO INSTALL SEPTIC TANK

Permit NO. _____ Permit Date June 19 195_

Owner Carl Chambers Address Hwy 21

Installed By CLYDE HOKE Address _____


Location of Property On Left past Prison Camp On #21

Tank		Capacity		Length of Lines		Fixtures	
Block	( )	800	(4)	150'	(4)	No. of Baths	( )
Precast	(4)	900	( )	175'	( )	Dishwasher	( )
		1000	( )	200'	( )	Garbage Grdr.	( )
LASH		1100	( )	225'	( )	Auto-Washer	( )
		1200	( )	250'	( )	Other _____	
		Other _____		Other _____			

NOTIFY HEALTH DEPARTMENT AT LEAST EIGHT HOURS BEFORE TANK IS TO BE INSPECTED.

Final Inspection June 17 1959 Approved ( ) Disapproved ( )

Remarks Not for Washer — Self Supp.

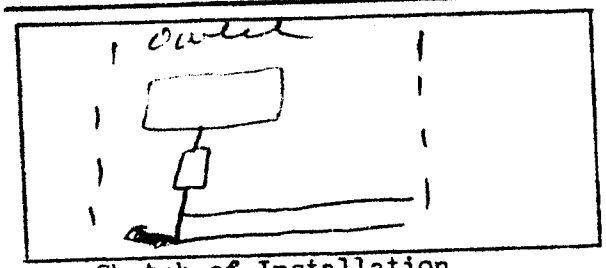

Sketch of Installation

Raymond G. Howard

Sanitarian