IREDELL COUNTY HEALTH DEPARTMENT

Statesville Phone TR 3-7271 — Mooresville Phone NO 3-1271

PERMIT TO INSTALL SEPTIC TANK

Permit No. 175 — Permit Date _____ 19__

Owner Wade Blackwelder — Address Statesville

Installed By Same — Address "


Location of Property N. on #21. First brick house on right after Prison Camp.

Tank		Capacity		Length of Lines		Fixtures	
Block	( )	1000	(✓)	225'	( )	No. of Baths	(2)
Precast	(✓)	1250	( )	250'	( )	Dishwasher	( )
		1500	( )	Other App. 266		Garbage Grdr.	( )
		Other _____				Other _____	

NOTIFY HEALTH DEPARTMENT AT LEAST EIGHT HOURS BEFORE TANK IS TO BE INSPECTED.

Final Inspection 3-10-19 21 — Approved (✓) Disapproved ( )

Remarks not much fall from tank.

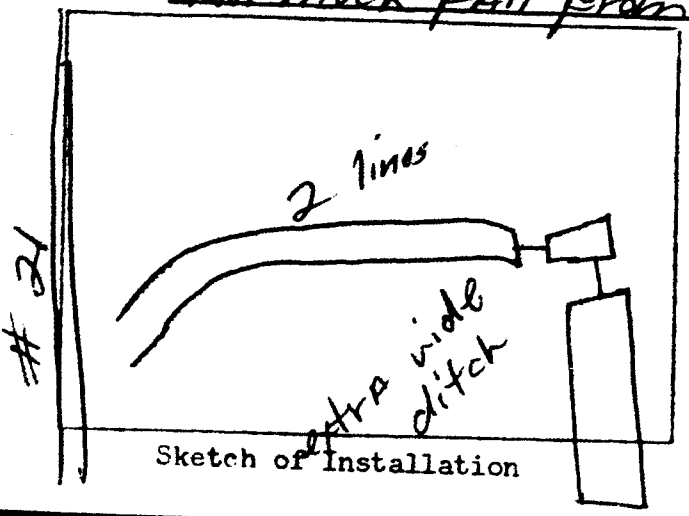

Sketch of Installation

Cress S. Hall

Sanitarian