ICHD - ENVIRONMENTAL HEALTH DIVISION

Statesville Office (704) 878-5305 Mooresville Office (704) 660-3625 (BB) PERMIT # AP-316008

SEPTIC: IMPROVEMENT PERMIT / AUTHORIZATION TO CONSTRUCT / OPERATION PERMIT / EXISTING SYSTEM

PIN # 4757 -- 24 -- 8210

APPLICANT/OWNER: LENTZ WASTEWATER / CRETE CARRIER Corp APPLICANT ADDRESS: 463 LENTZ ROAD, STATESVILLE, NC 28625

SITE ADDRESS: 139 BETHANY ROAD, STATESVILLE, N.C. 28625 PHONE: 980-829-3278 ALT. PHONE 704-880-3435

SITE DIRECTIONS: (N) ON 77, (R) ON 21, (L) ON BETHANY, LOT ON (L)

SUBDIVISION: — SECTION: — LOT # — LOT AREA: 9.27 AC

SAP CONTROLLED: [ ] YES [ ] NO EXT

DESIGN FLOW: EXT L.T.A.R.: EXT


Septic Tank	~~1000~~ / 1500 (gal)	STB	964	Date	2/23	[ ] New System	[x] Repair	[ ] Expansion	System Type: I II (III) IV V VI	[ ] Residence	No. Bedrooms —
Pump Tank	— (gal)	PT	—	Date	—	System Description:	EXT-50% REDUCTION			[x] ~~Business~~	No. Persons —
Pump Make	—	Model	—	Serial #	—	Repair System Description:	TANK REPLACEMENT			[ ] Other	No. Employees 14
# Nitrification Fields	1-EXT	# Lines	2-EXT	Linear Ft	150FT-EXT	Maintenance Agreement Required:	[ ] YES	[x] ~~NO~~		[x] ~~Stab~~	[ ] Crawl Space
Trench Width	EXT	Trench Bottom Depth(Low side)	EXT	Gravel Depth	—		[x] ~~GRAVITY~~	[ ] PRESSURE		[ ] Basement w/plumbing	[ ] Basement w/o plumbing

Water Supply: [ ] Private [x] ~~Public~~ [ ] Community

Comments / Conditions: PUMP, CRUSH, AND FILL EXISTING TANK, INSPECT AND REPLACE D-BOX AS NEED, DRAINLINES APPEARED TO BE FUNCTIONING AT TIME OF INSPECTION


DO NOT EXCEED 36 IN of COVER ON TANK OR TRAFFIC RATED TANK IS REQUIRED, NO INDUSTRIAL WASTE TO BE GOING INTO SYSTEM DOMESTIC WASTE ONLY

INITIAL SITE SKETCH

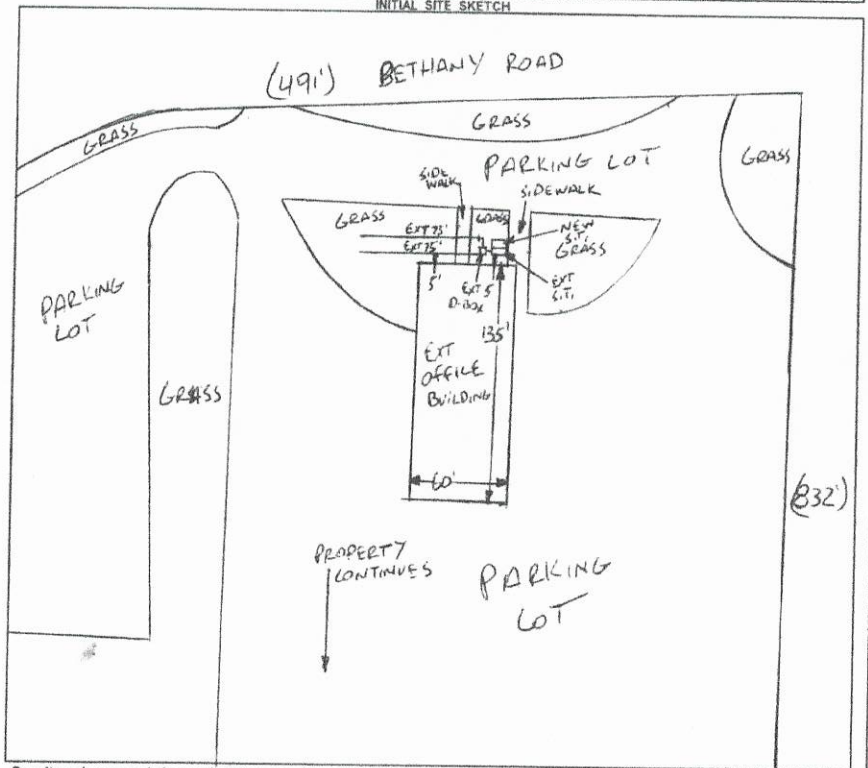

AS BUILT SKETCH

FOR SEPTIC FINAL INSPECTION CALL: 704-664-3703 between 8am-9am the day the inspection is needed. Be sure to speak with an inspector to confirm your time.

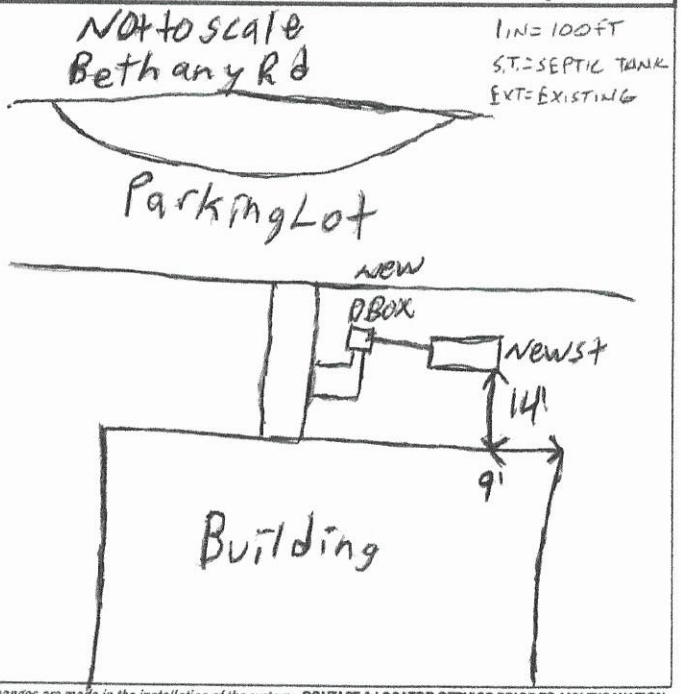

Permit can be suspended or revoked if any false information is supplied toward securing the permit / any unauthorized changes are made to the site / any unauthorized changes are made in the installation of the system. **CONTACT A LOCATOR SERVICE PRIOR TO ANY EXCAVATION**

[ ] **IMPROVEMENT PERMIT** *with plat valid without expiration.* [x] **IMPROVEMENT PERMIT** *with site plan valid for 60 mos.* [ ] ~~**AUTHORIZATION TO CONSTRUCT**~~ *valid for period equal to IMPROVEMENT PERMIT--not to exceed 60 mo.*

Owner / Applicant Signature: Carla C. Nicks Date: 4-1-21 Installed by: Lentz

IMPROVEMENT PERMIT by: Bryant Cubitt Date: 4-1-2021 OPERATION PERMIT by: Patrick J Byle III Date: 4/9/2021

AUTHORIZATION TO CONSTRUCT by: Bryant Cubitt Date: 4-1-2021 Existing System Inspected by: Date:

FOR SEPTIC FINAL INSPECTION: CALL 704-664-3703 between 8am-9am the day the inspection is needed

RECEIVED MAR 2 2 2021

APPLICATION MUST BE FILLED OUT COMPLETELY & BE LEGIBLE OR IT WILL NOT BE PROCESSED

Iredell County Health Department – Environmental Health Division

PAGE 1: *APPLICATION FORM*

AP-316008 Repair Eval

Application For: ( ) New Well Permit ( ) Well Repair Permit ( ) Well Abandonment
( ) Septic Improvement Permit ( ) Authorization to Construct ( ) Existing System Inspection (✓) Septic System Repair

THE ABOVE PERMIT DOCUMENTS WILL BECOME INVALID IF INFORMATION PROVIDED ON THIS APPLICATION IS FALSIFIED OR CHANGED, OR IF THE SITE IS ALTERED. THE IMPROVEMENT PERMIT IS VALID FOR EITHER 60 MONTHS OR WITHOUT EXPIRATION DEPENDING UPON DOCUMENTATION SUBMITTED. APPLICATION WITH SITE PLAN 60 MONTHS, APPLICATION WITH COMPLETE, SCALED PLAT WITHOUT EXPIRATION. SEE 15A NCAC 18A .1937(f) FOR DETAILS.

Page 2: *Site Plan Worksheet* form MUST accompany this application

The following optional attachments may also be submitted: ( ) Survey Plat, scaled no more than 1 inch = 60 feet
Place an (X) beside whichever is submitted if applicable (✓) Custom Site Plan, scaled no more than 1 inch = 60 feet

Applicant Information: (PRINT CLEARLY)

Applicant Name: Lentz Wastewater Mgmt Address: 413 Lentz Rd Statesville NC Zip: 28625
Applicant Email: carla@lentzwastewater.com Phone: 980-829-3278 Alt. Phone: 704-880-3435
Owner Name: Crete Carrier Corp Address: 400 NW 56th St Lincoln, NE Zip: 68528
Owner Email: pmarsh@cretecarriers.com Phone: 402-475-9521 Alt. Phone: –

Property Information:

Street Address: 139 Bethany Rd, Statesville
Subdivision Name: – Section/Phase: – Lot Number: –
Driving Directions: 21 N → left on Bethany Rd → on left

Site Development Information: *(check or complete ALL that apply*

CHECK FOUNDATION TYPE

( ) New Single Family Residence
( ) New Multi-Family Residence
( ) Accessory Building
( ) Bedroom(s) Addition
(✓) Repair to failing septic system ✓ Tank ___ Drain lines Describe Problem: damaged tank (tank is exposed)
Maximum Number of Bedrooms: _____
Maximum Number of Occupants: _____
( ) Swimming Pool
( ) Other Addition/Structure: _____
( ) Crawl Space Foundation
(✓) Concrete Slab Foundation
( ) Basement with Plumbing
( ) Basement without Plumbing

Non-Residential Site Development: Type of Business: trucking company
Square Footage of Building: ext Max. Number of Employees: ext Max. Number of Seats/Beds/Other: _____

Water Supply: ( ) Replacement Well – Reason: _____
( ) Multi-connection Well Number of Houses: _____ Number of Persons: _____

( ) New Well ( ) Existing Well ( ) Community Well ( ) City Water (✓) Other Public Water

Desired Septic System Type: *(you may rank in order of preference)* Year existing system installed: 1989
( ) No Preference ( ) Alternative ( ) Conventional ( ) Innovative ( ) Modified Conventional ( ) Other: _____

Please answer the following to the best of your ability:
( ) Yes (✓) No Does the site contain any jurisdictional wetlands?
( ) Yes (✓) No Is any non-domestic sewage (i.e. industrial) to be generated?
( ) Yes (✓) No Is the site subject to approval by any other public agency?

I have read this application and certify that the information provided herein is true, complete, and correct. Authorized county and state officials are granted right of entry to conduct necessary inspections to determine compliance with applicable laws and rules. I understand that I am solely responsible for the proper identification and labeling of all property lines and corners and making the site accessible so that a complete site evaluation can be performed.


Signature: Carla C. Nicles 3-18-21
Property owner or owner's legal representative signature (SIGNATURE REQUIRED) DATE

IREDELL COUNTY HEALTH DEPARTMENT

ENVIRONMENTAL HEALTH DIVISION

PAGE 2: *SITE PLAN WORKSHEET*

SEE THE "SAMPLE SITE PLAN" BELOW. *INCOMPLETE SITE PLANS WILL BE RETURNED TO YOU FOR COMPLETION AND MAY RESULT IN A DELAY IN THE ISSUANCE OF YOUR SEPTIC SYSTEM PERMIT!!!*

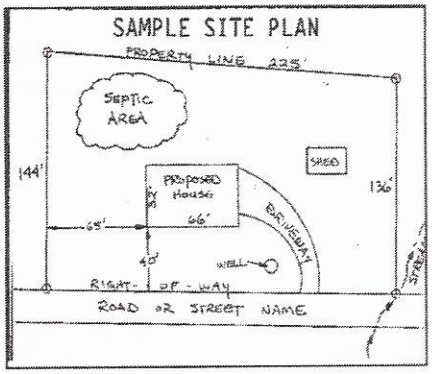

Place an (X) beside each item as you complete the site plan:


- ( ) **Property Line measurements are clearly identified**
- ( ) **All proposed structures are indicated**
- ( ) **Front and side setbacks from property line**
- ( ) **Preferred driveway location and well location**
- ( ) **Area you prefer your septic system to be placed**
- ( ) **North arrow, or other sufficient indicator of direction**

Circle N/A on the following if appropriate:

Location of septic systems and wells within 100' of your property	**N/A**
Location of easements and rights of ways on your property	**N/A**
Location of any designated wetlands on the property	**N/A**

USE THIS SPACE TO DRAW YOUR SITE PLAN

Show: proposed house or business footprint, wells, water lines, patios, pools and decks, and any other item that will occupy space on the site

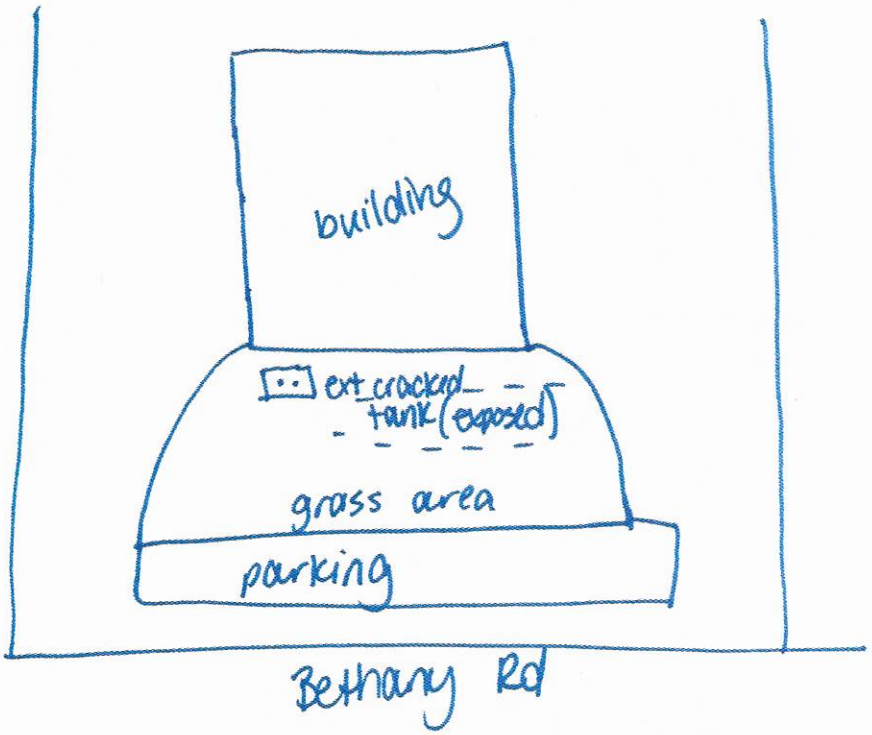

Signature: Carla C. Nicks
Property owner or owner's legal representative signature (SIGNATURE REQUIRED)

3-18-21
DATE

9830

IREDELL COUNTY HEALTH DEPARTMENT

(SEPTIC TANK) IMPROVEMENTS PERMIT AND CERTIFICATE OF COMPLETION
(Ground Absorption Sewage Disposal System -- G. S. Chapter 130-Article 13C)

OWNER OR CONTRACTOR Nelda J. Davis DATE 10-5-89 PERMIT NO. _____

PHONE: Business _____ Home _____

LOCATION 2 IN Leon Bethany Vermi on left.

_____ S. R. No. _____

SUBDIVISION NAME _____ LOT NO. _____ SECTION OR BLOCK NO. _____


House ( ) Mobile Home ( ) Business ( ) Other Trucking Terminal Revision of Permit Date) 4-5-89

No. Bedrooms _____ No. Bathrooms _____
Garbage Disposal Unit Yes ( ) No ( )
Auto. Dishwasher Yes ( ) No ( )
Auto. Wash. Machine Yes ( ) No ( )
Site Suitable Yes ( ) No ( )

Character & Porosity of Soil Clayey
Percolation Rate 48
Topography Slope
Depth to Water Table 10'+
Rock or other impervious formations None

Lot Area _____

_____ Basement with Plumbing _____ Basement without Plumbing _____ No Basement

 

Plot of System

Size of Tank 1250 Gals.
Nitrification Field:
No. of Lines 2
Sq. Ft. _____ Linear Ft. _____
Depth of Stone in Lines _____
Water Supply: Individual ( )
Public ( )
150' of 16" Panel

Installed by Tommy Eyer

I understand and agree to install septic tank system as specified on this Improvements Permit.

Signed: _____

IMPROVEMENTS PERMIT BY [redacted] Kelly Sheeks

COMMENTS: System was installed deep due to depth of stub out

CERTIFICATE OF COMPLETION BY _____ DATE 11-6-89

EXISTING SYSTEM CHECKED BY: _____ DATE _____

CONSTRUCTION MUST COMPLY WITH ALL OTHER APPLICABLE STATE AND LOCAL REGULATIONS.

Permit is VOID if any unauthorized changes are made in installation of system and/or if any false information is supplied in making Improvements Permit.

Health Dept. Copy: White Inspection Dept. Copy: Yellow Sanitarian's Copy: Pink Owner's Copy: Gold

IREDELL COUNTY DEPARTMENT OF ENVIRONMENTAL HEALTH

DOCUMENTATION TO AUTHORIZE AN OWNER'S LEGAL REPRESENTATIVE

(Check and sign only ONE of the options below)

☐ **1. * APPLICANT AND OWNER ARE THE SAME. *** (*Sign here*) _____

Applications for permits require the "signature of the owner or owner's legal representative" (15A NCAC 18A .1937). If the owner does not sign the application himself or herself, they can submit any one of the following documents to designate their legal representative: *Power of Attorney; Real Estate Contract; Estate executor; Bankruptcy trustee; Court ordered guardianship* In the absence of the above documentation, the property owner may provide the local health department with documentation that designates a legal representative. A property owner may:
Complete this form to document his or her legal representative, or provide his or her own form that contains the information in this form. If there are multiple property owners, then all property owners must sign the form that designates a legal representative.
By signing a form that designates a legal representative for purposes of 15A NCAC 18A .1937, the property owner authorizes that representative to act on their behalf in matters pertaining to the application and permitting process, including signing or receiving any application, document or permit. The owner retains full responsibility to meet all permit conditions specified by the local health department.

☑ **2.** I, Crete Carrier Corp., am the legal owner(s) of the property located at 139 Bethany Rd, Statesville, identified as PIN (Parcel Identification Number) 4757248210, located in Iredell County, North Carolina.

I do hereby authorize (**print legal representative/company name**) Carla Nicks, Lentz Wastewater Management, to act as an agent on my behalf in applying for/signing/obtaining any of the documents described below.

- Application for Improvement Permit (IP) / Authorization to Construct (AC)
- Improvement Permit (IP) / Authorization to Construct (AC)
- Application for soil-site evaluation (new/repair)
- Application/permit for private drinking water well/well abandonment
- Application for Compliance Inspection

I agree to abide by all decisions and/or conditions between the legal representative acting on my behalf and the Iredell County Department of Public Health, Environmental Health Division.

Signature of Owner(s) _____ Date 03/19/2021

Mooresville - Environmental Health
Fax: 704-662-3239
610 E. Center Avenue, Mooresville, NC 28115

Statesville - Environmental Health
ronda.hart@co.iredell.nc.us
Fax: 704-871-3483
349 N. Center Street, Statesville, NC 28677