IREDELL COUNTY HEALTH DEPARTMENT

STATESVILLE 704-878-5305 MOORESVILLE 704-664-5281

IMPROVEMENT PERMIT / AUTHORIZATION TO CONSTRUCT / OPERATION PERMIT / EXISTING SYSTEM INSPECTION

PERMIT# 101013 PIN# 4757-24-8711 DATE 7-18-01

OWNER OR CONTRACTOR DIXIELAND INC PHONE: Business (704) 202-4971 Home

ADDRESS 4474 LAKE DR, SHERRILLS FORD NC 28673

LOCATION US 21 N, TL BETHANY RD, TR GILEAD LAKE, 3RD LOT ON LEFT

SUBDIVISION ~~BETHANY TRACE~~ BLOCK / SECTION LOT LOT AREA 0.459 ACRE SITE CLASS PS DESIGN FLOW 360 L.T.A.R. 0.25 GPD/FT²

Septic Tank: 1000 Gallons; STB 825 Date 9-24-01
Pump Tank: Gallons; PT Date
Pump Make: Model Serial No
Nitrification Field: No Fields 1 Square Feet Eq. To 1440 Linear Feet 240
No Lines SIX Trench Width 24" Max Trench Bottom Depth 36" ~~Gravel~~ Depth SAND 6"

☑ New System ☐ Repair System Type: I, II, (III), IV, V
System Description: 50% REDUCTION GRAVITY
Repair System Description: 50% REDUCTION LOW PRES.
Maintenance Agreement Required: ☐ Yes ☑ No
☐ Slab ☑ Crawl Space ☐ Basement w/plumbing ☐ Basement wo/plumbing


☑ House/Mod. Home No. Bedrooms 3
☐ Mobile Home No. Bathrooms 2
☐ Business No. Employees
☐ Other

Water Supply: ☐ Individual ☑ Public ☐ Community


Comments/Conditions: ① CONTACT HEALTH DEPT. PRIOR TO INSTALLATION TO FLAG OUT SYSTEM ② INSTALL 54' PPBRS PANELS IN SIX EQUAL LENGTH LINES

Comments/Conditions: SEPTIC TANK WITH MARKER INSTALLED USING "POLYLOK" FILTER

INITIAL SITE SKETCH

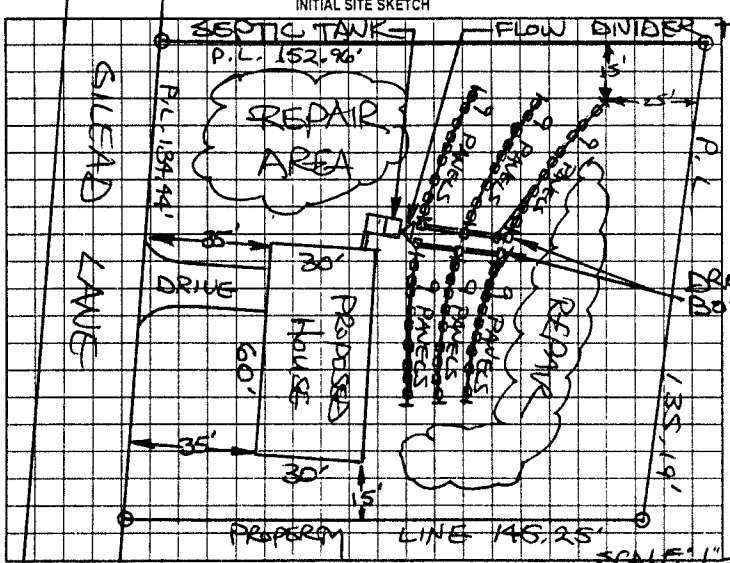

AS BUILT SKETCH

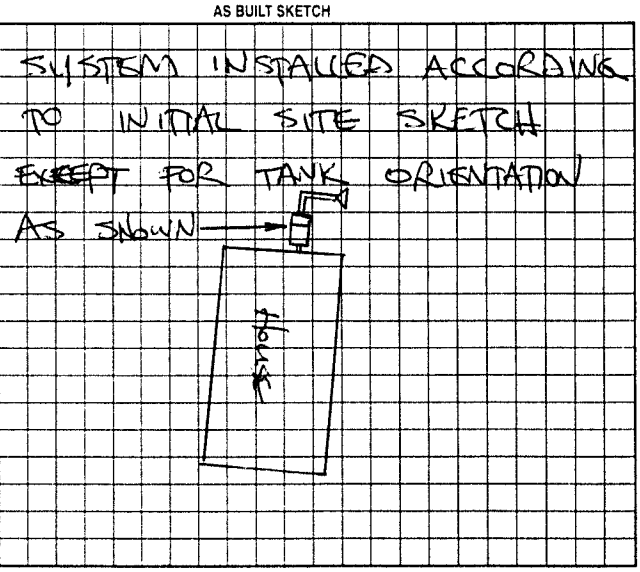

Permit can be suspended or revoked if any false information is supplied toward securing the permit/any unauthorized changes are made to the site/any unauthorized changes are made in the installation of the system. Improvement Permit with plat valid without expiration. Improvement Permit with site plan valid for sixty months. Authorization to Construct is valid for a period equal to that of Improvement Permit – not to exceed sixty months.

Signed: Miguel Cicci date 7/18/01 Installed by: ROWAN SEPTIC TANK

Improvement Permit by: STEVE HEDRICK date 7-18-01 Operation Permit by: STEVE HEDRICK date 11-15-01

Authorization to Construct by: STEVE HEDRICK date 7-18-01 Existing System Inspection by: date

HEALTH DEPT. COPY: WHITE OWNER COPY (FINAL): YELLOW OWNER COPY (INITIAL): PINK