IREDELL COUNTY HEALTH DEPARTMENT

STATESVILLE 704-878-5305 MOORESVILLE 704-664-5281

IMPROVEMENT PERMIT / AUTHORIZATION TO CONSTRUCT / OPERATION PERMIT / EXISTING SYSTEM INSPECTION

PERMIT# 75117 PIN# 4757352459 DATE 9-5-98

OWNER OR CONTRACTOR Dixieland Inc. PHONE: Business 928 478 5331 Home

ADDRESS 4474 Lake Dr. Sherrills Ford N.C. 28673

LOCATION 21 N TL Bethany Rd TR Oileal 5th lot on left

SUBDIVISION Bethany Tr. BLOCK / SECTION 2 LOT 3 LOT AREA .64 acres SITE CLASS. PS DESIGN FLOW 360 L.T.A.R. 128

Septic Tank: 1000 Gallons; STB 825 Date 10-27-98 ☑ New System ☐ Repair System Type: I, II, III, IV, V, VI

Pump Tank: Gallons; PT Date System Description: Gravity 25% Reduction 3/4

Pump Make: Model Serial No. Repair System Description: Pump to Panels

Nitrification Field: No Fields 1 Square Feet 960 Linear Feet 320 Maintenance Agreement Required: ☐ Yes ☑ No

No Lines 4 Trench Width 36" Max Trench Bottom Depth 36" Gravel Depth N/A

☑ House/Mod. Home No. Bedrooms 3

☐ Mobile Home No. Bathrooms 2

☐ Business No. Employees

☐ Other

☐ Slab ☐ Crawl Space ☐ Basement w/plumbing ☐ Basement wo/plumbing


Water Supply: ☐ Individual ☑ Public ☐ Community

Comments:/Conditions:


Comments:/Conditions:

* upper two line longer shorten lower two due to gulley

INITIAL SITE SKETCH

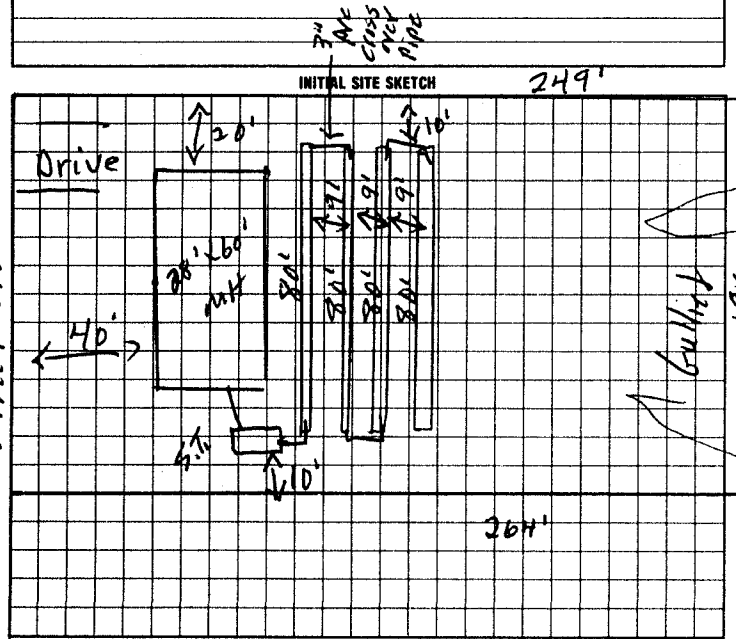

AS BUILT SKETCH

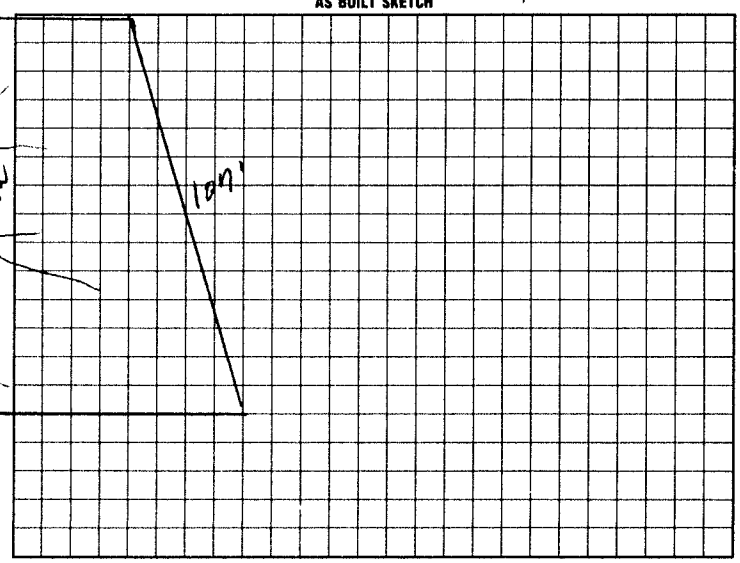

I understand that this permit can be suspended or revoked if any false information is supplied toward securing the permit/any unauthorized changes are made to the site/any unauthorized changes are made in the installation of the system. Improvement Permit with plat valid without expiration. Improvement Permit with site plan valid for sixty months. Authorization to Construct is valid for a period equal to that of Improvement Permit – not to exceed sixty months.

Signed: date 10/26/98 Installed by: Rowan Septic

Improvement Permit by: P.C. Moore date 9-5-98 Operation Permit by: [illegible] EOJ RS date 2-25-99

Authorization to Construct by: P.C. Moore date 9-5-98 Existing System Inspection by: date

HEALTH DEPT. COPY: WHITE INSPECTION COPY (FINAL): GREEN OWNER COPY (FINAL): YELLOW INSPECTION COPY (INITIAL): PINK OWNER COPY (INITIAL): GOLD