IREDELL COUNTY HEALTH DEPARTMENT

STATESVILLE 704-878-5305 MOORESVILLE 704-664-5281

IMPROVEMENT PERMIT / AUTHORIZATION TO CONSTRUCT / OPERATION PERMIT / EXISTING SYSTEM INSPECTION

PERMIT# 75118 PIN# 4757352459 DATE 9-5-98

OWNER OR CONTRACTOR Dixieland Inc. PHONE: Business 828 478 5331 Home

ADDRESS 4474 Lake Dr. Sherrills Ford

LOCATION 21 N TL Bethany Rd TR Gilead 6th ~~Home~~ lot left

SUBDIVISION Bethany Trace BLOCK / SECTION LOT 4 LOT AREA .69 acres SITE CLASS PS DESIGN FLOW 360 L.T.A.R. .28

Septic Tank: 1000 Gallons; STB 825 RST Date 6-15-00

Pump Tank: Gallons; PT Date

Pump Make: Model Serial No.

Nitrification Field: No Fields 1 Square Feet 960 Linear Feet 320

No Lines 4 Trench Width 36" Max Trench Bottom Depth 36" Gravel Depth N/A

☐ ~~New System~~ ☐ Repair System Type: I II III IV V VI

System Description: Gravity 25% Reduction

Repair System Description: Pump To Panels

Maintenance Agreement Required: ☐ Yes ☒ ~~No~~

☐ ~~House~~/Mod. Home ☐ ~~Mobile Home~~ ☐ Business ☐ Other

No. Bedrooms 3 No. Bathrooms 2 No. Employees

☐ Slab ☐ Crawl Space ☐ Basement w/plumbing ☐ Basement wo/plumbing

Water Supply: ☐ Individual ☒ Public ☐ Community


Comments:/Conditions:

8-16-00 Oked by phone to use Drop Panels DRH


3" Sch 40 PVC pipe 24" D.I.

Comments:/Conditions:

INITIAL SITE SKETCH

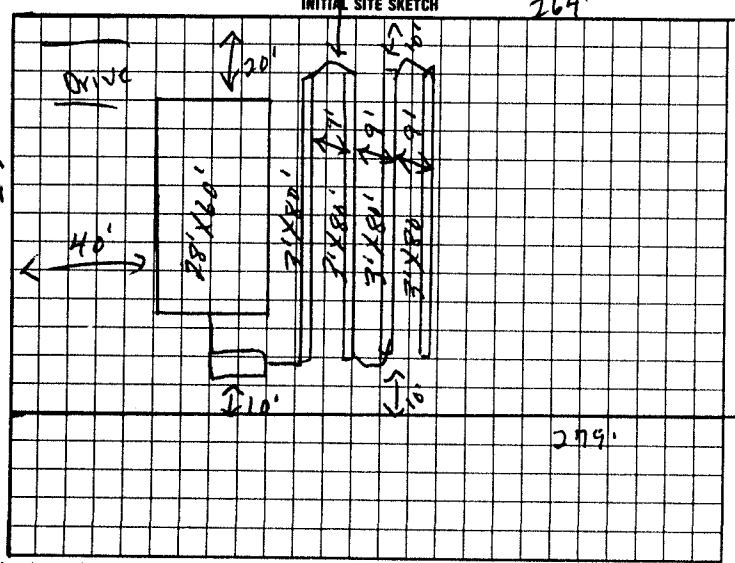

AS BUILT SKETCH

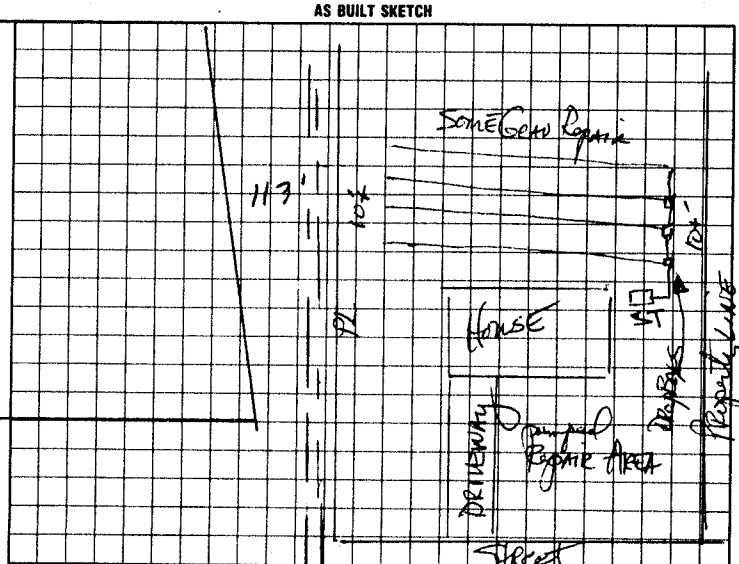

I understand that this permit can be suspended or revoked if any false information is supplied toward securing the permit/any unauthorized changes are made to the site/any unauthorized changes are made in the installation of the system. Improvement Permit with plat valid without expiration. Improvement Permit with site plan valid for sixty months. Authorization to Construct is valid for a period equal to that of Improvement Permit -- not to exceed sixty months.

Signed: date 10/26/98

Improvement Permit by: R.C. Moore date 9-5-98

Authorization to Construct by: R.C. Moore date 9-5-98

Installed by: Rooney Septic Tank date

Operation Permit by: DR Huffman IRS date 8-16-00

Existing System Inspection by: date

HEALTH DEPT. COPY: WHITE INSPECTION COPY (FINAL): GREEN OWNER COPY (FINAL) YELLOW INSPECTION COPY (INITIAL) PINK OWNER COPY (INITIAL): GOLD

1131'

63 270 6 Panels