IREDELL COUNTY HEALTH DEPARTMENT

STATESVILLE 704-878-5305 (C1) MOORESVILLE 704-664-5281

IMPROVEMENT PERMIT / AUTHORIZATION TO CONSTRUCT / OPERATION PERMIT / EXISTING SYSTEM INSPECTION

PERMIT# 075119 PIN# 4757 35 2459 (PT) DATE 7-12-01

OWNER OR CONTRACTOR DIXIELAND, INC PHONE: Business (704) 202-4971 Home (704) 483-2127

ADDRESS 4474 LAKE DRIVE, SHERRILLS FORD, NC 28673

LOCATION US 21 NORTH, TL BETHANY RD, TR GILEAD LANE, 7TH LOT ON LEFT

SUBDIVISION BETHANY TRACE BLOCK / SECTION I LOT 5 LOT AREA 0.739 ACRE SITE CLASS PS DESIGN FLOW 360 L.T.A.R. 0.25 GPD/FT²

Septic Tank: 1000 Gallons: STB 825 Date 6-18-01
Pump Tank: ____ Gallons: PT ____ Date ____
Pump Make: ____ Model ____ Serial No. ____
Nitrification Field: No Fields 1 Square Feet EQ. TO 1440 Linear Feet 240
No Lines SIX Trench Width 24" Max Trench Bottom Depth 36" Gravel Depth SAND 6"

☑ New System ☐ Repair System Type: I, II, III, IV, V, VI
System Description: 50% REDUCTION GRAVITY
Repair System Description: 50% REDUCTION, LPP
Maintenance Agreement Required: ☐ Yes ☑ No
☐ Slab ☐ Crawl Space ☑ ~~Basement w/plumbing~~ ☑ Basement wo/plumbing


☐ House/Mod. Home No. Bedrooms 3
☐ Mobile Home No. Bathrooms 2
☐ Business No. Employees ____
☐ Other ____

Water Supply: ☐ Individual ☑ Public ☐ Community


Comments/Conditions: ① CONTACT HEALTH DEPT. PRIOR TO INSTALLATION TO FLAG OUT SYSTEM. ② INSTALL 54 PPBRS PANELS IN SIX EQUAL LENGTH LINES ON CONTOUR AS SHOWN.

Comments/Conditions: SEPTIC TANK WITH RISERS & MARKER INSTALLED USING "Poly Lok" FILTER

INITIAL SITE SKETCH

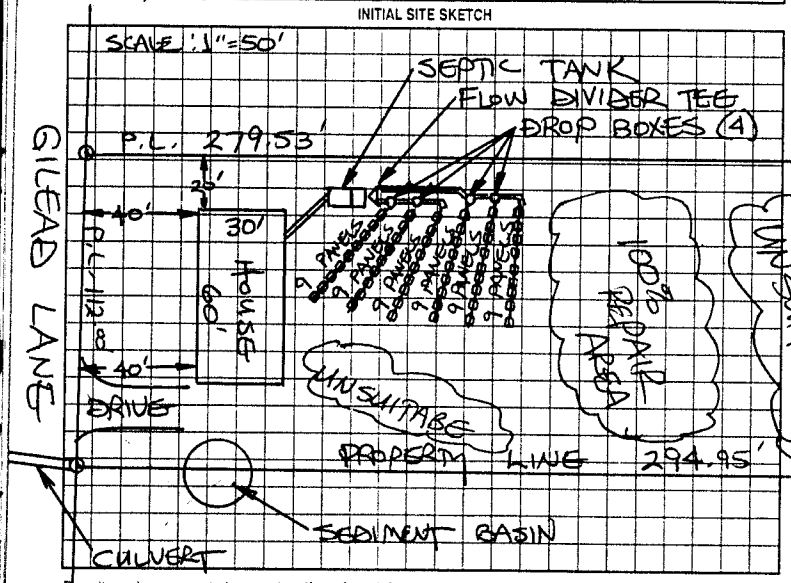

AS BUILT SKETCH

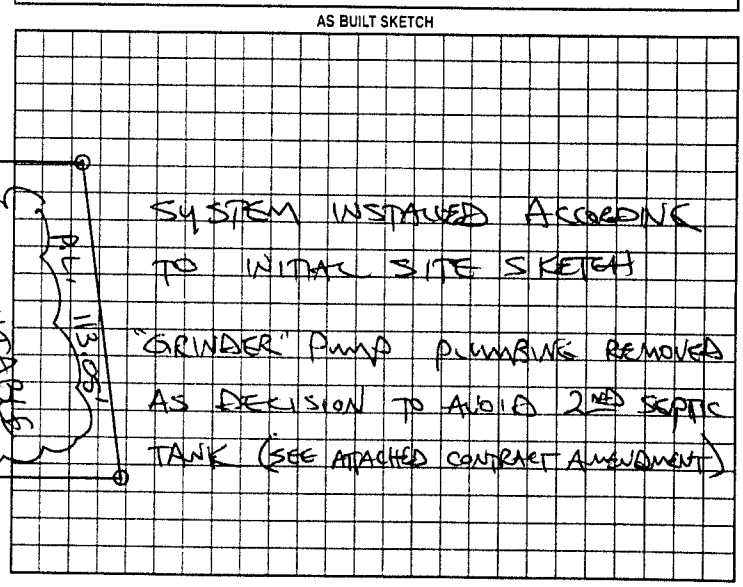

Permit can be suspended or revoked if any false information is supplied toward securing the permit/any unauthorized changes are made to the site/any unauthorized changes are made in the installation of the system. Improvement Permit with plat valid without expiration. Improvement Permit with site plan valid for sixty months. Authorization to Construct is valid for a period equal to that of Improvement Permit – not to exceed sixty months.

Signed: [signature] date 7/18/01 Installed by: ROMAN SEPTIC TANK

Improvement Permit by: STEVE HEDRICK date 7-12-01 Operation Permit by: STEVE HEDRICK date 6-25-02

Authorization to Construct by: STEVE HEDRICK date 7-12-01 Existing System Inspection by: ____ date ____

HEALTH DEPT. COPY: WHITE OWNER COPY (FINAL): YELLOW OWNER COPY (INITIAL): PINK