# IREDELL COUNTY HEALTH DEPARTMENT

STATESVILLE 704-878-5305 MOORESVILLE 704-664-5281

## IMPROVEMENT PERMIT / CERTIFICATE OF COMPLETION / OPERATION PERMIT / EXISTING SYSTEM INSPECTION

PROPERTY DESCRIPTION NO. 16645 DATE 7-15-93 TAX MAP NO. 106-A-75 A

OWNER OR CONTRACTOR Harry Reep PHONE: Business Home 876 2700

ADDRESS Rt 15 Box 184 Statesville

LOCATION 21 N past DoT Dept AT Turner Nursery TR Private Rd at end Rt

SUBDIVISION BLOCK / SECTION LOT LOT AREA Ample SITE CLASS. PS L.T.A.R. 0.406 GPD/FT

Water Supply: ☐ Individual ☐ Community ☒ Public

Septic Tank: 1000 Gallons; STB 1012 Date 5/29/93

Pump Tank: Gallons; PT Date

Nitrification Field: No Fields 1 Square Feet 600 Linear Feet 200

No Lines 2 Trench Width 36 Trench Depth 24 Gravel Depth 12

☒ New System ☐ Repair System Type: I. (II.) III. IV. V. VI

System Description: Conv. Gravity

Repair System Description: " "

Maintenance Agreement Required: ☐ Yes ☒ No

☐ House/Mod. Home ☒ Mobile Home ☐ Business ☐ Other

No. Bedrooms 2 No. Bathrooms 2 No. Employees

☐ Slab ☒ Crawl Space ☐ Basement w/plumbing

Garbage Disposal: ☐ Yes ☒ No

Auto. Dishwasher: ☐ Yes ☒ No

Auto. Washing Machine: ☒ Yes ☐ No

Other


☐ Basement wo/plumbing

Comments


① SYSTEM OPEN DURING PERIOD OF RAIN WHICH MAY AFFECT SYSTEM LIFESPAN

② KEEP MH MINIMUM 5' FROM SYSTEM

**INITIAL SITE SKETCH**

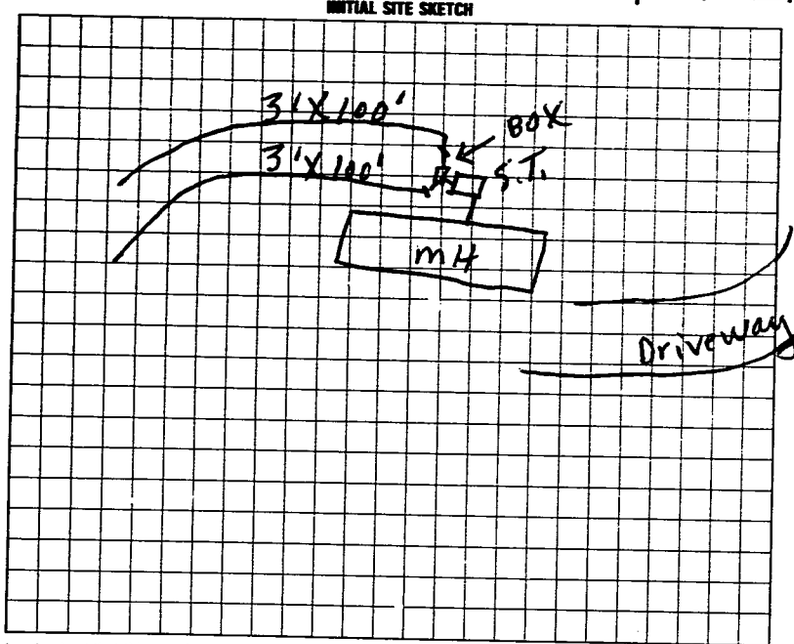


**AS BUILT SKETCH**

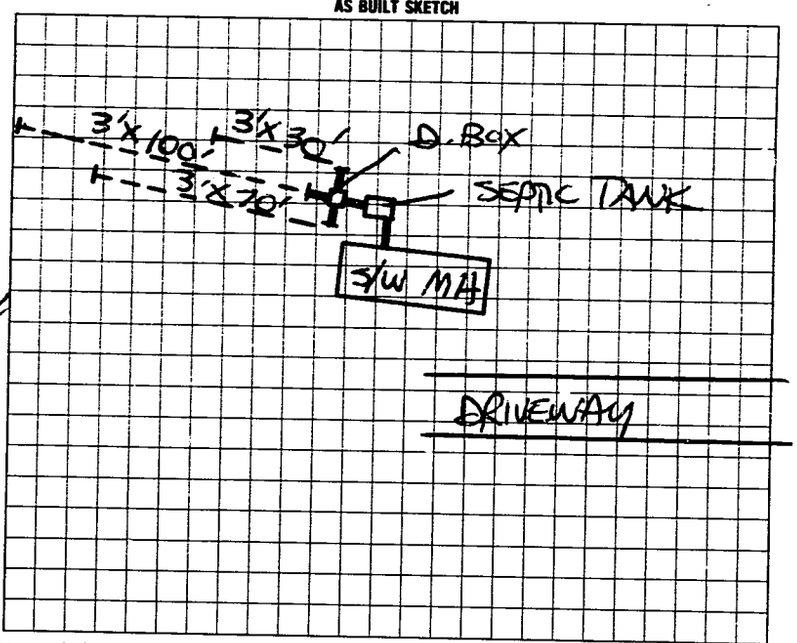


I understand that this permit can be suspended or revoked if any false information is supplied toward securing the permit/any unauthorized changes are made to the site/any unauthorized changes are made in the installation of the system. Improvement Permit is valid for 60 months from date of issuance.

Signed: Harry Reep

Improvement Permit by: R. C. Moore date 7-15-93

Existing System Inspection by: date

Installed by: HARRY REEP

Certificate of Completion by: STEVE HEDRICK date 8/13/93

Operation Permit by: date

HEALTH DEPT. COPY: WHITE INSPECTION COPY (FINAL): GREEN OWNER COPY (FINAL): YELLOW INSPECTION COPY (INITIAL): PINK OWNER COPY (INITIAL): GOLD