IREDELL COUNTY HEALTH DEPARTMENT

STATESVILLE 704-878-5305 MOORESVILLE 704-664-5281

IMPROVEMENT PERMIT / AUTHORIZATION TO CONSTRUCT / OPERATION PERMIT / EXISTING SYSTEM INSPECTION

PERMIT# 150798 PIN# 4757-32-1816 DATE 20 June 08

OWNER OR APPLICANT Randy Neal PHONE: Business 704-902-7360 Home

ADDRESS 545 Black Welden Rd. Statesville, N.C.

LOCATION Turnersburg Nal - Nly 2/N - DN RH past Peaceful Lp. on Rt.

SUBDIVISION BLOCK / SECTION 1 LOT LOT AREA 1 0.6ac. SITE CLASS. PS DESIGN FLOW 360gpd L.T.A.R. 0.3/475gpd

Septic Tank: 1000g Gallons: STB 1012 Date 10-29-07

Pump Tank: Gallons: PT Date

Pump Make: Model Serial No.

Nitrification Field: No Fields 1 Square Feet ≈1000 Linear Feet 300

No Lines 4 Trench Width 30" Max Trench Bottom Depth 36 Gravel Depth

☑ New System ☐ Repair ☐ Expansion System Type: I II (III) IV V VI

System Description: 2550 Reduction

Repair System Description: 2550 Reduction

Maintenance Agreement Required: ☐ Yes ☑ No

☑ House/Mod. Home No. Bedrooms 3

☐ Mobile Home No. Persons

☐ Business No. Employees

☐ Other

Water Supply: ☐ Individual ☑ Public ☐ Community

☑ Gravity ☐ Pressure ☐ Slab ☑ Crawl Space ☐ Basement w/plumbing ☐ Basement wo/plumbing

Comments/Conditions: Follow contour / Honor all setback requirements.

Comments/Conditions: Infiltrative filter. (Marker on ST)

INITIAL SITE SKETCH

Please see Attached Layout

AS BUILT SKETCH

Installed as Drawn

Permit can be suspended or revoked if any false information is supplied toward securing the permit/any unauthorized changes are made to the site/any unauthorized changes are made in the installation of the system. Improvement Permit with plat valid without expiration ☐ Improvement Permit with site plan valid for sixty months ☑ Authorization to Construct valid for a period equal to that of Improvement Permit – not to exceed sixty months.

Signed: Randy Neal date 6-20-08

Improvement Permit by: R.S. date 20 June 08

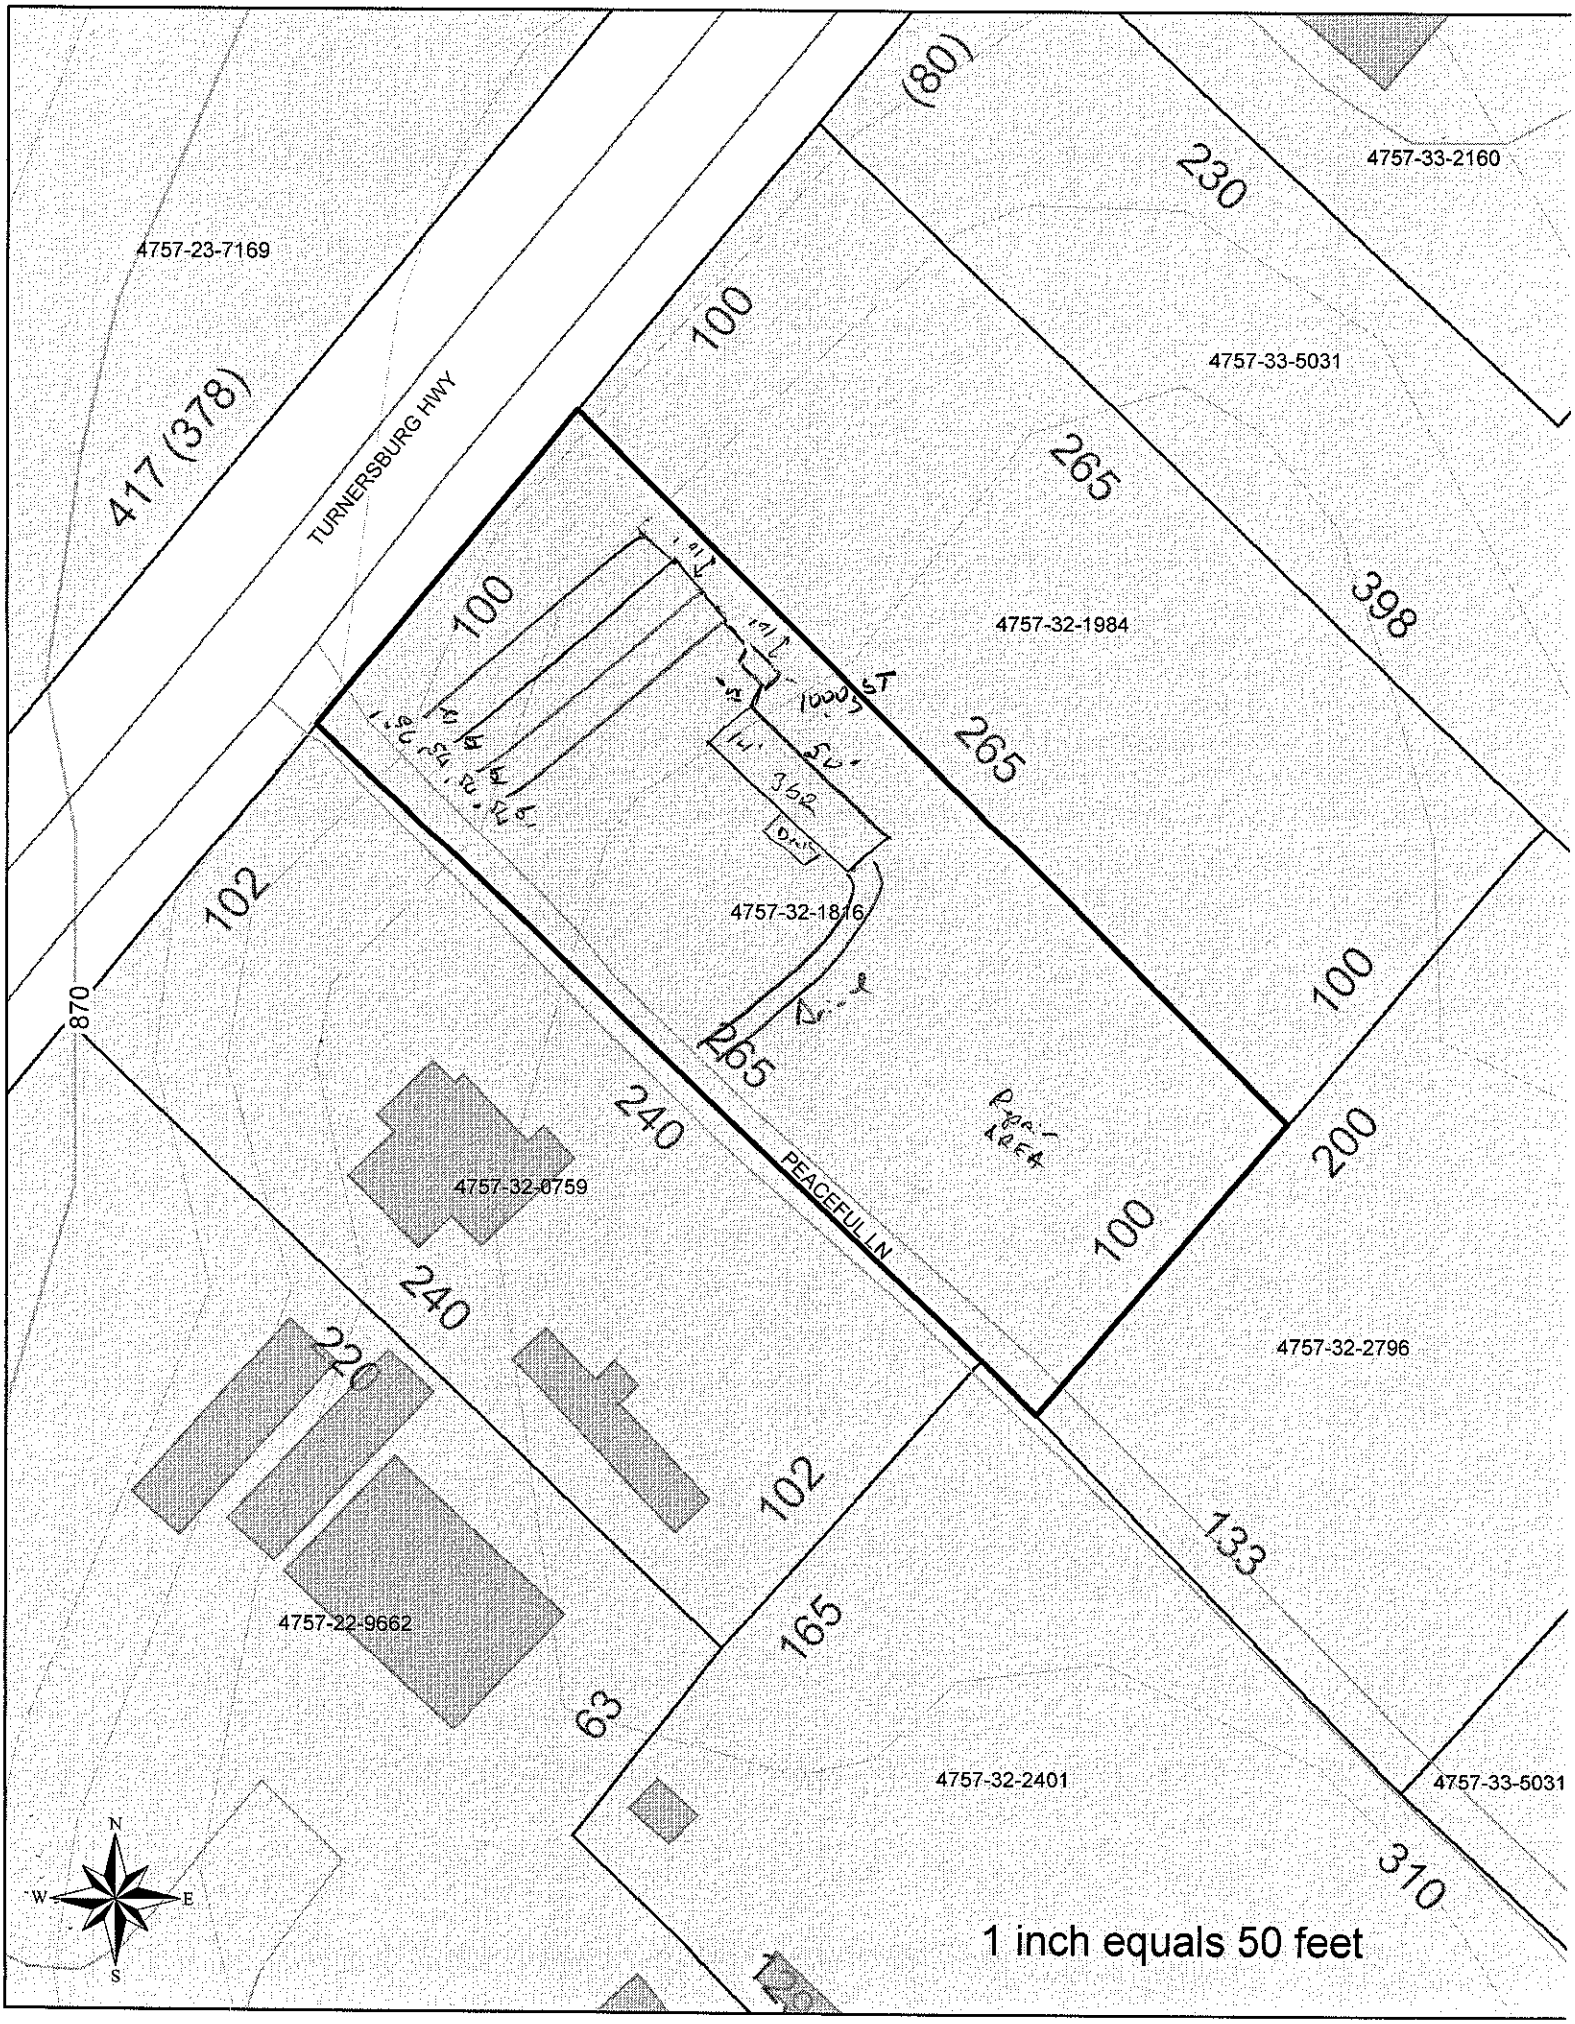
Authorization to Construct by: R.S. date 1 Aug 08

Installed by: Cindy Thompson

Operation Permit by: R.S. date 18 Aug 08

Existing System Inspection by: date

HEALTH DEPT. COPY: WHITE OWNER COPY (FINAL): YELLOW OWNER COPY (INITIAL): PINK


4757-23-7169
TURNERSBURG HWY
417 (378)
(80)
4757-33-2160
230
100
4757-33-5031
265
398
4757-32-1984
100
265
102
4757-32-1816
870
100
265
240
PEACEFUL LN
200
100
4757-32-0759
240
4757-32-2796
220
102
133
4757-22-9662
165
63
4757-32-2401
4757-33-5031
310
N
W
E
S
1 inch equals 50 feet