IREDELL COUNTY HEALTH DEPARTMENT

STATESVILLE 704-878-5305 MOORESVILLE 704-664-5281

IMPROVEMENT PERMIT / AUTHORIZATION TO CONSTRUCT / OPERATION PERMIT / EXISTING SYSTEM INSPECTION

PERMIT# 150798 PIN# 4757-32-1816 DATE 20 June 08

OWNER OR APPLICANT Randy Neal PHONE: Business 704-902-7360 Home

ADDRESS 545 Blackwelder Rd. Statesville, N.C.

LOCATION Turnersburg Nc - Hwy 21 N - DN RH past Peaceful Lu. on RH.

SUBDIVISION BLOCK / SECTION LOT LOT AREA 1.0 Ac. SITE CLASS. PS DESIGN FLOW 360 gpd L.T.A.R. 0.3 x 472 = 142

Septic Tank: 1000 Gallons: STB 1012 Date 10-29-07

Pump Tank: Gallons: PT Date

Pump Make: Model Serial No.

Nitrification Field: No Fields 1 Square Feet ≈ 1200 Linear Feet 300

No Lines 4 Trench Width 30" Max Trench Bottom Depth 36

☑ New System ☐ Repair ☐ Expansion System Type: I II (III) IV V VI

System Description: 2550 Reduction

Repair System Description: 2550 Reduction

Maintenance Agreement Required: ☐ Yes ☒ No

Gravel Depth ☑ Gravity ☐ Pressure

☑ House/Mod. Home No. Bedrooms 3

☐ Mobile Home No. Persons

☐ Business No. Employees

☐ Other

Water Supply: ☐ Individual ☒ Public ☐ Community

☐ Slab ☒ Crawl Space ☐ Basement w/plumbing ☐ Basement wo/plumbing

Comments/Conditions: Follow Contour / Honor all setback requirements.

Comments/Conditions: Infil. trench / Marker on ST /

INITIAL SITE SKETCH

Please see Attached Layout

AS BUILT SKETCH

Installed as Drawn

The proposed / existing Carport addition does not appear to impact the existing septic system.

**NOTE: * See Attached Site Plan

R.S.

Date: 20 November 09

ICHD-Environmental Health Division

Permit can be suspended or revoked if any false information is supplied toward securing the permit/any unauthorized changes are made to the site/any unauthorized changes are made in the installation of the system. Improvement Permit with plat valid without expiration ☐ Improvement Permit with site plan valid for sixty months ☑ Authorization to Construct valid for a period equal to that of Improvement Permit – not to exceed sixty months.

Signed: Randy Neal date 6-20-08

Improvement Permit by: R.S. date 20 June 08

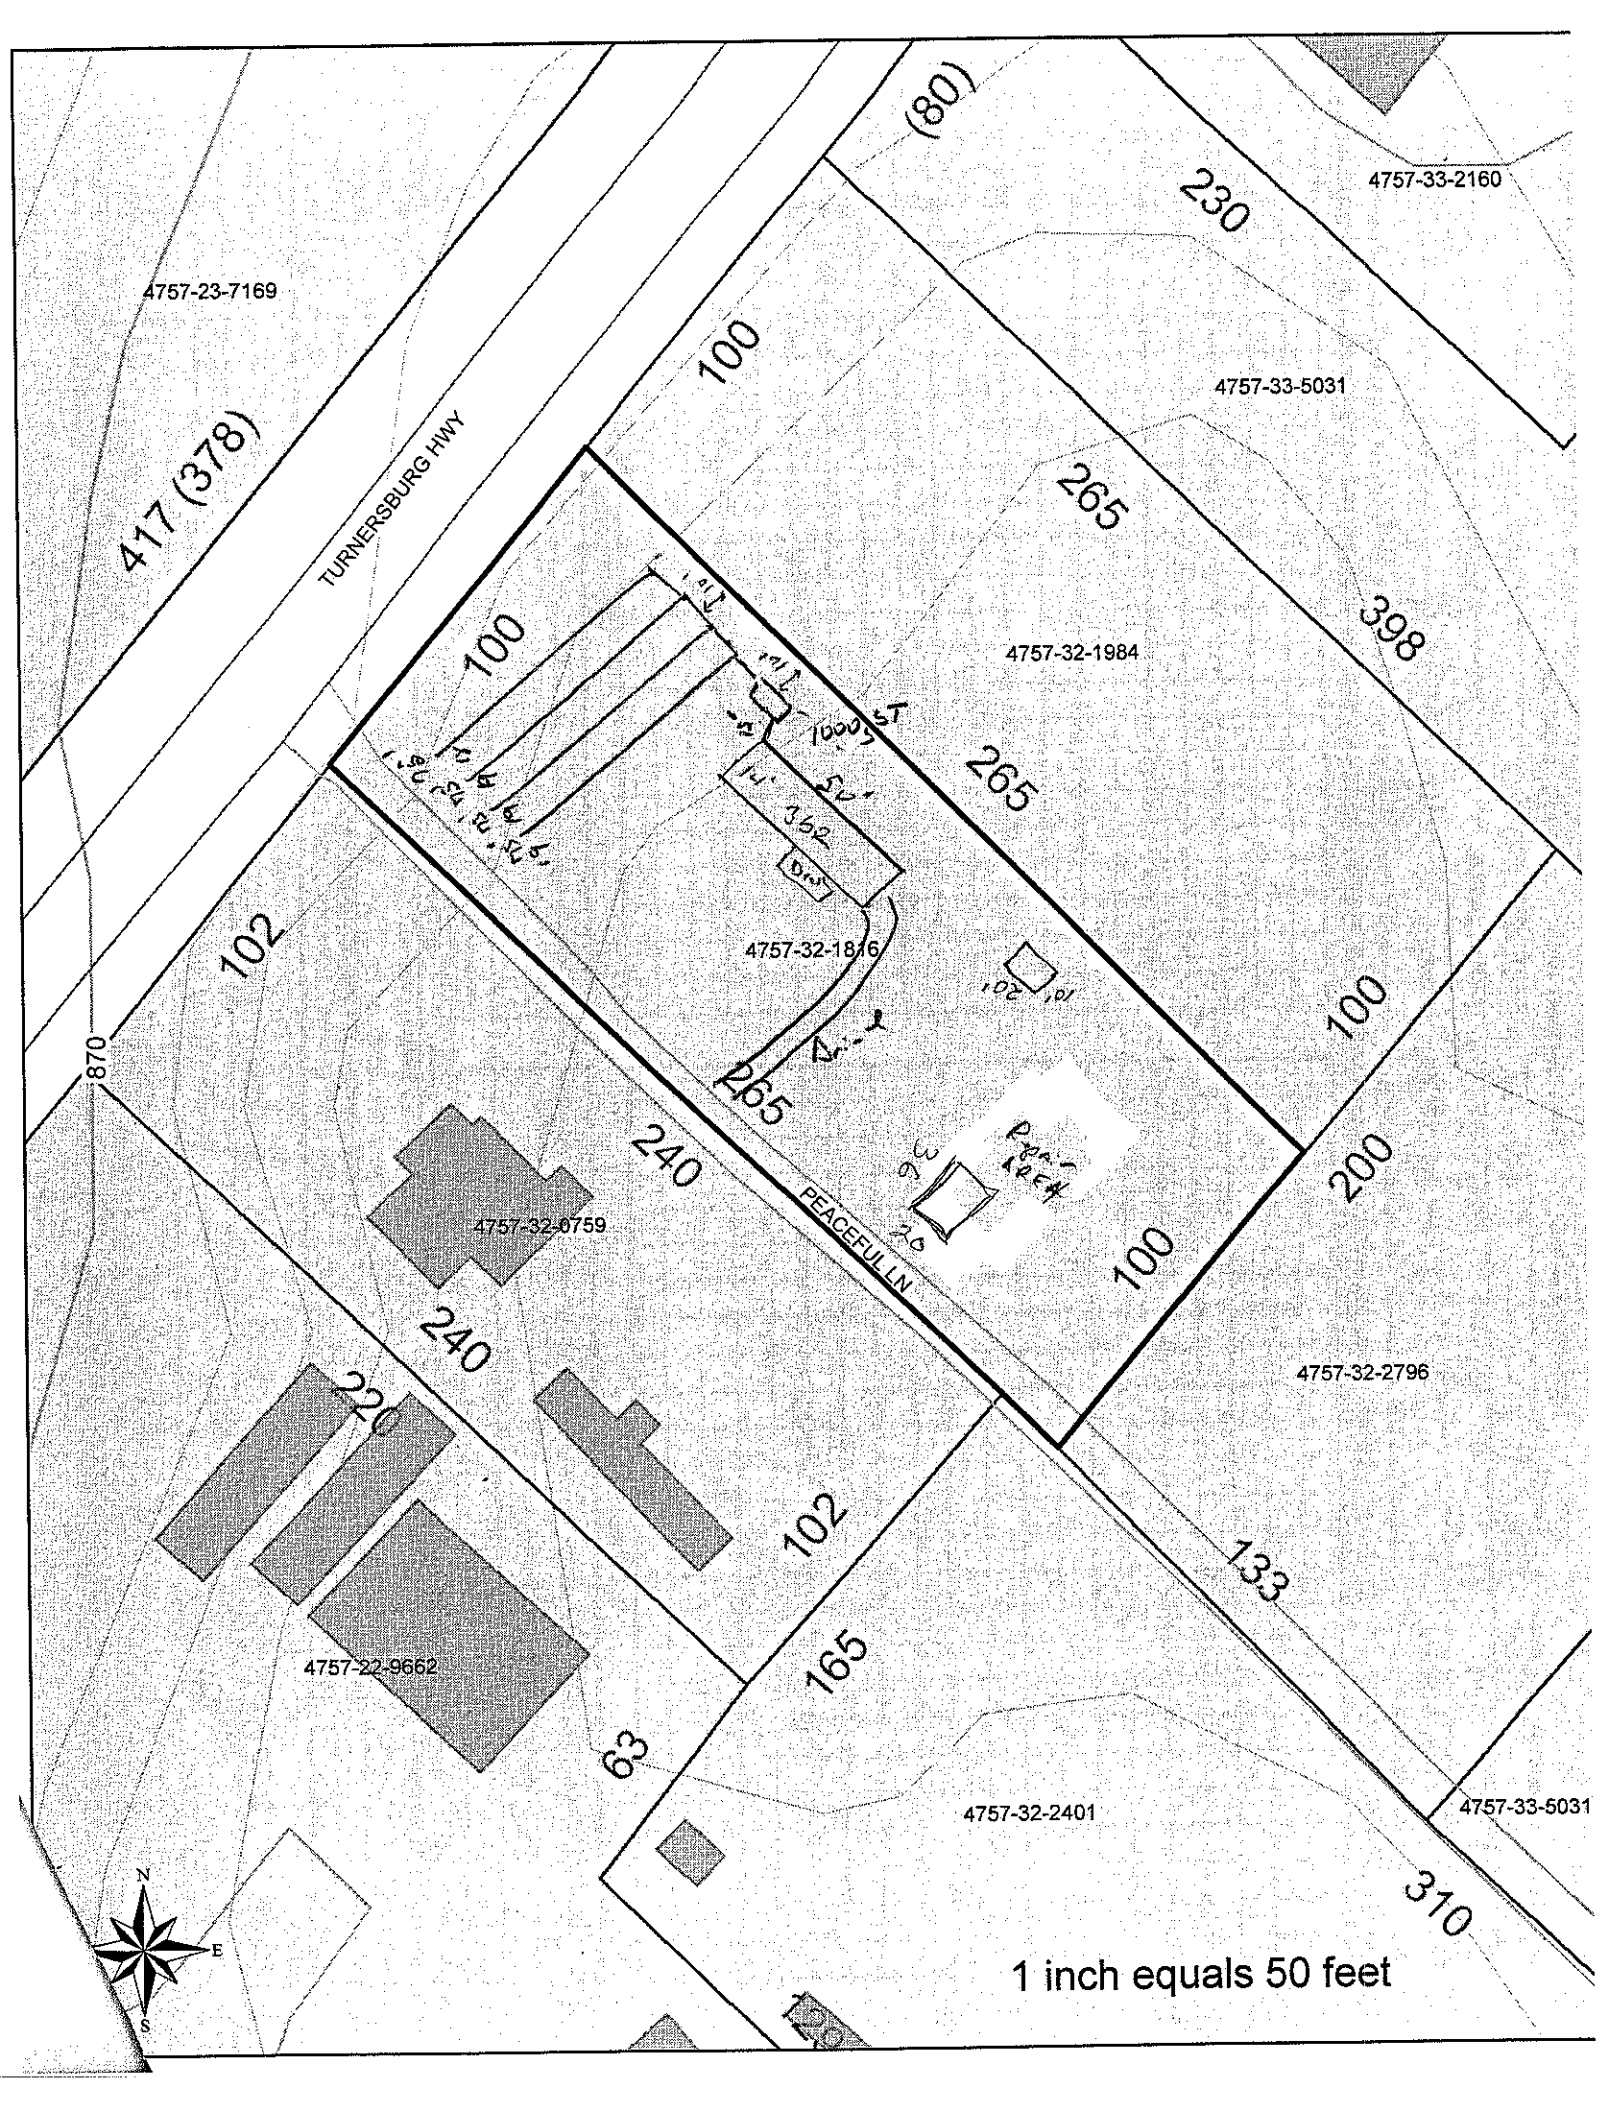
Authorization to Construct by: R.S. date 1 Aug-08

Installed by: Craig Thompson

Operation Permit by: R.S. date 18 Aug 08

Existing System Inspection by: date

HEALTH DEPT. COPY: WHITE OWNER COPY (FINAL): YELLOW OWNER COPY (INITIAL): PINK


4757-23-7169
TURNERSBURG HWY
417 (378)
(80)
230
4757-33-2160
100
4757-33-5031
265
398
4757-32-1984
100
265
102
4757-32-1816
870
100
265
240
PEACEFUL LN
4757-32-0759
200
100
240
4757-32-2796
220
102
133
165
4757-22-9662
63
4757-32-2401
4757-33-5031
310
N
E
S
1 inch equals 50 feet