IREDELL COUNTY HEALTH DEPARTMENT

STATESVILLE 704-878-5305 MOORESVILLE 704-664-5281

IMPROVEMENT PERMIT / AUTHORIZATION TO CONSTRUCT / OPERATION PERMIT / EXISTING SYSTEM INSPECTION

PERMIT # 158553 PIN # 4757-32-5042 DATE 27 October 09

OWNER or APPLICANT Delayne Whitaker / Clayton Hu PHONE: Business (704) 873-2547 Home:

OWNER or APPLICANT ADDRESS 146 Peaceful Land Statesville, N.C.

LOCATION / DIRECTIONS Hwy 21 N TR Peaceful Lane - Go to end on Rt. - 146 Peaceful Lane

SUBDIVISION BLOCK / SECTION LOT # LOT AREA 0.56ac. DESIGN FLOW 360 g/d L.T.A.R. 0.3 g/ft²/d

Septic Tank 1000 Gallons: STB 1012 Date 9-18-07
Pump Tank Gallons: P T Date
Pump Make Model Serial #
Nitrification Field No Fields 1 No Lines 3 Linear Feet 300
Trench Width 36" Max. Trench Bottom Depth 36" Gravel Depth NA

☑ New System ☐ Repair ☐ Expansion System Type I II III IV V VI
System Description: 25% Reduction Syst
Repair System Description: 25% Reduction Syst
Maintenance Agreement Required ☐ YES ☑ NO
☑ GRAVITY ☐ PRESSURE


☑ Residence No. Bedrooms 3
☐ Business No. Persons
☐ Other No. Employees
☐ Slab ☑ Crawl Space
☐ Basement w/plumbing ☐ Basement w/o plumbing

Water Supply: ☑ Private ☐ Public ☐ Community


Comments / Conditions: Follow contour / Keep well / 100' from system. /

Comments / Conditions: Polyluck fill -

INITIAL SITE SKETCH

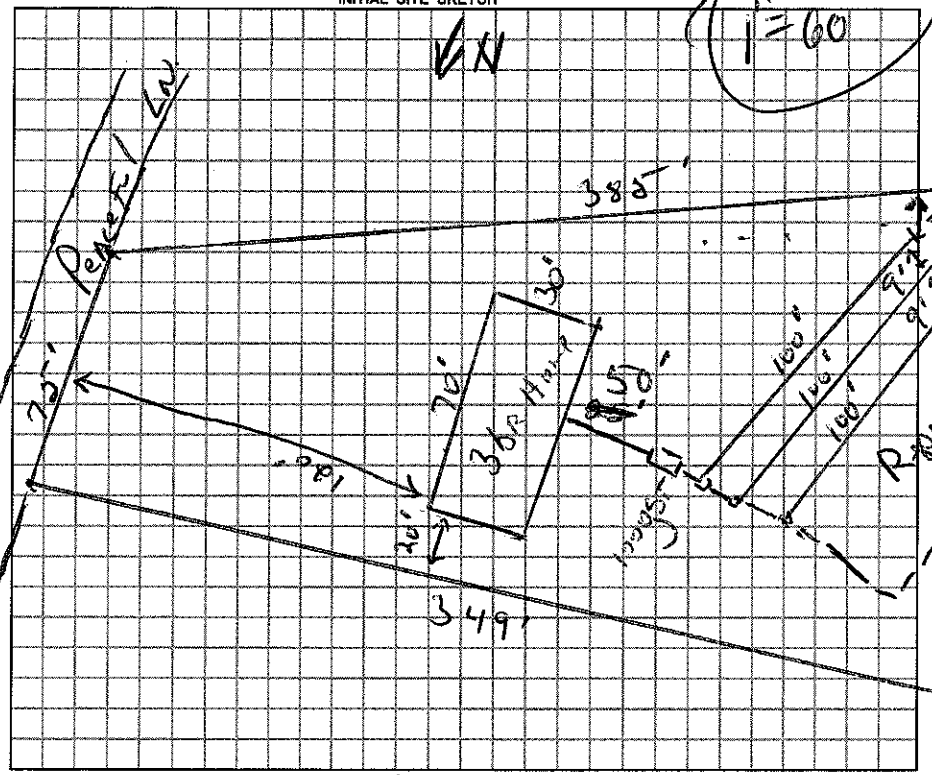

AS BUILT SKETCH

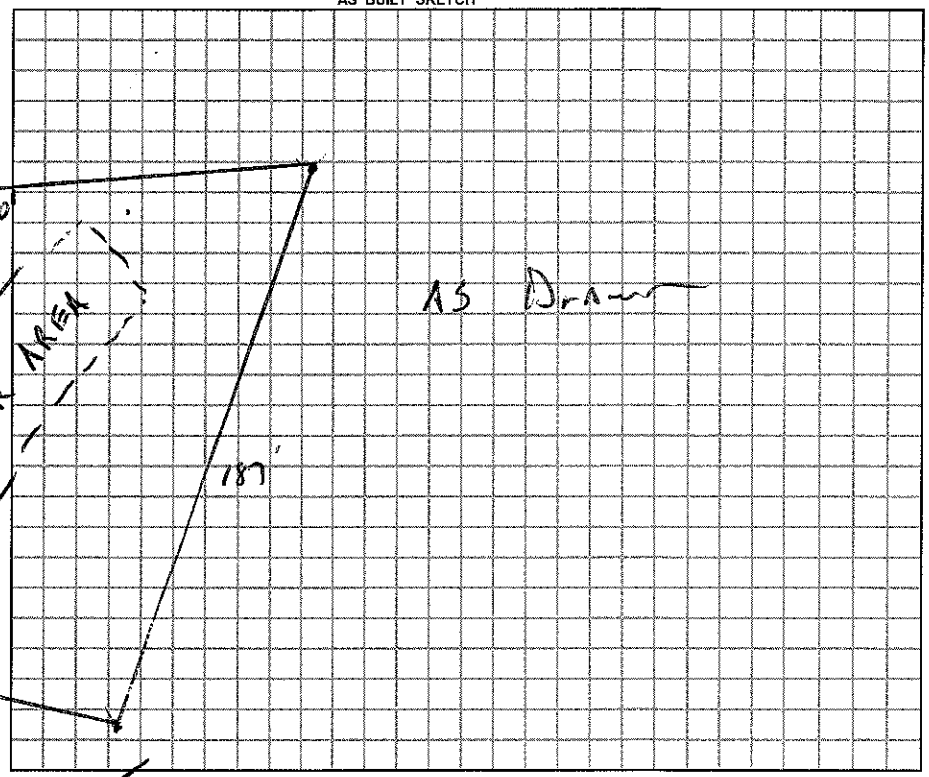

Permit can be suspended or revoked if any false information is supplied toward securing the permit / any unauthorized changes are made to the site / any unauthorized changes are made in the installation of the system.

☐ *IMPROVEMENT PERMIT w / plat valid without expiration.* ☑ *IMPROVEMENT PERMIT w / site plan valid for 60 mos.* ☑ *AUTHORIZATION TO CONSTRUCT valid for period equal to IMPROVEMENT PERMIT-not to exceed 60 mo.*

Owner / Applicant Signature: Date 10/28/09 Installed by:

Improvement Permit by: R.S. Date 27 October 09 Operation Permit by: R.S. Date: 12 Nov 09

Authorization to Construct by: R.S. Date 27 October 09 Existing System Inspected by: Date:

YOU SHOULD CONTACT A LOCATOR SERVICE PRIOR TO ANY EXCAVATION.

WHITE COPY Environmental Health YELLOW COPY (Final) Owner / Applicant PINK COPY (Initial) Owner / Applicant