# IREDELL COUNTY HEALTH DEPARTMENT

STATESVILLE 704-878-5305 MOORESVILLE 704-664-5281

## IMPROVEMENT PERMIT / CERTIFICATE OF COMPLETION / OPERATION PERMIT / EXISTING SYSTEM INSPECTION

PROPERTY DESCRIPTION NO. 16431 DATE June 1, 1993 TAX MAP NO. Pt of 106-A-75

OWNER OR CONTRACTOR Harry Reep PHONE: Business 876-2770 Home Same

ADDRESS Rt 18 Box 184 Statesville, N.C.

LOCATION US 21 N Past Prison Camp TR beside T+T Nursery 1/8 mi on RT

SUBDIVISION BLOCK / SECTION LOT LOT AREA 3.1 acres SITE CLASS. PS L.T.A.R. .35

Water Supply: ☐ Individual ☐ Community ☑ Public

Septic Tank: 1000 Gallons; STB 1012 Date 3-19-93

Pump Tank: Gallons; PT Date

Nitrification Field: No Fields 3 Square Feet 1048 Linear Feet 345

No Lines 3 Trench Width 36" Trench Depth 24" Gravel Depth 12"

☑ New System ☐ Repair System Type: I, II, IV, V, VI

System Description: S.T. + Conv Grav. Drain line

Repair System Description:

Maintenance Agreement Required: ☐ Yes ☑ No

☐ House/Mod. Home ☑ Mobile Home ☐ Business ☐ Other

No. Bedrooms 3 No. Bathrooms 2 No. Employees

☐ Slab ☑ Crawl Space ☐ Basement w/plumbing ☐ Basement wo/plumbing

Garbage Disposal: ☐ Yes ☑ No


Auto. Dishwasher: ☐ Yes ☑ No

Auto. Washing Machine: ☑ Yes ☐ No

Other

Comments

**INITIAL SITE SKETCH**

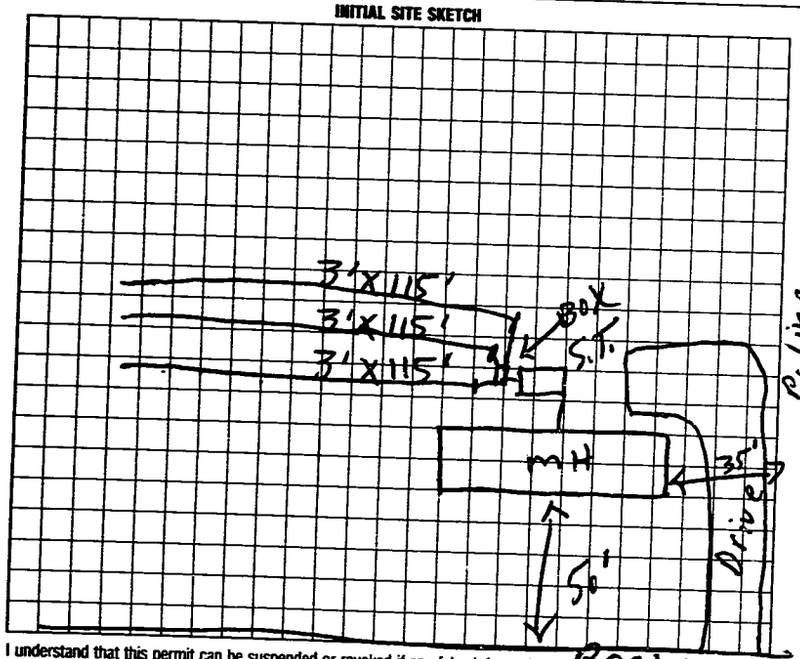


**AS BUILT SKETCH**

Same as initial sketch

I understand that this permit can be suspended or revoked if any false information is supplied toward securing the permit/any unauthorized changes are made to the site/any unauthorized changes are made in the installation of the system. Improvement Permit is valid for 60 months from date of issuance.

Signed: x Harry Reep

Improvement Permit by: F. C. Moore date 6-1-93

Existing System Inspection by: date

Installed by: Harry Reep

Certificate of Completion by: F. C. Moore date 6-17-93

Operation Permit by: date

HEALTH DEPT. COPY: WHITE INSPECTION COPY (FINAL): GREEN OWNER COPY (FINAL): YELLOW INSPECTION COPY (INITIAL): PINK OWNER COPY (INITIAL): GOLD