IREDELL COUNTY HEALTH DEPARTMENT

STATESVILLE 704-878-5305 MOORESVILLE 704-664-5281

50856

IMPROVEMENT PERMIT / CERTIFICATE OF COMPLETION / OPERATION PERMIT / EXISTING SYSTEM INSPECTION

PROPERTY DESCRIPTION NO. 18158 DATE 8-8-94 TAX MAP NO. 106-A-48B Watershed: ☐ Yes ☒ No

OWNER OR CONTRACTOR Bobby S. Redmon PHONE: Business Home 876 3721

ADDRESS Rt 18 / Box 289-B Sta

LOCATION 21 N Pool Ebenezer Academy to Bethany Rd on left beside CC Freight

SUBDIVISION BLOCK / SECTION LOT LOT AREA .63 acre SITE CLASS PS DESIGN FLOW 360 L.T.A.R. .4

Septic Tank: EX 1000 Gallons; STB Date 6-7-88

Pump Tank: Gallons; PT Date

Pump Make: Model Serial No.

Nitrification Field: No Fields 1 Square Feet 300 Linear Feet 100

No Lines 2 Trench Width 36" Max Trench Bottom Depth 36" Gravel Depth 12"

☐ New System ☐ Repair . System Type: I, II, III, IV, V, VI

System Description: Addition to EX System conv. Gravity

Repair System Description:

Maintenance Agreement Required: ☐ Yes ☒ No

☒ House/Mod. Home No. Bedrooms 3

☐ Mobile Home No. Bathrooms 3

☐ Business No. Employees

☐ Other

☐ Slab ☒ Crawl Space ☐ Basement w/plumbing ☐ Basement wo/plumbing


Water Supply: ☐ Individual ☐ Community ☒ Public

Comments: Adding to EX system installed 6-7-88 1000 gal 200' Drain line Filter over Bobby Redmon


Existing mobile Home must be Pulled off site before House (3'X100' Addition line) is occupied

Comments:

INITIAL SITE SKETCH

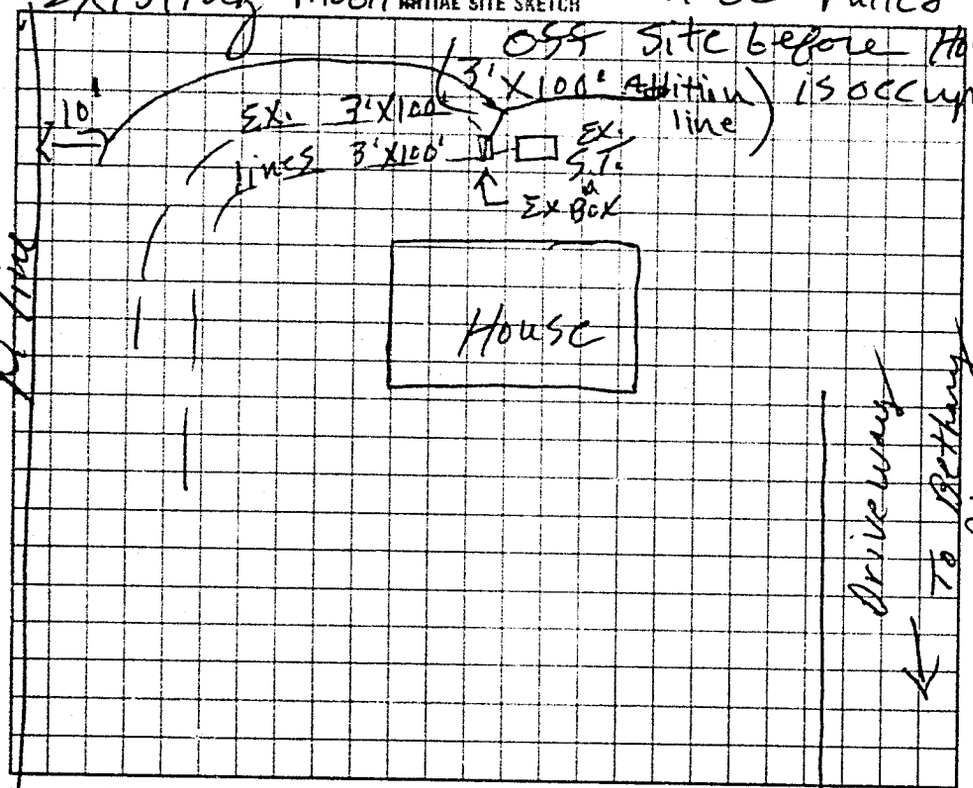

AS BUILT SKETCH

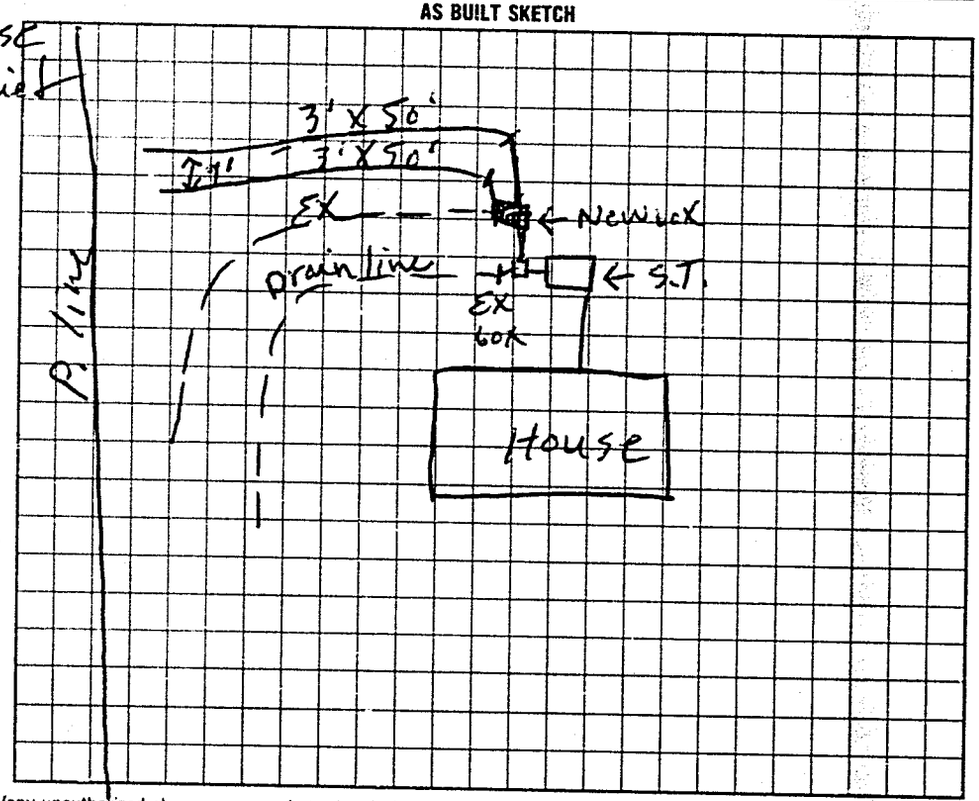

I understand that this permit can be suspended or revoked if any false information is supplied toward securing the permit/any unauthorized changes are made to the site/any unauthorized changes are made in the installation of the system. Improvement Permit is valid for 60 months from date of issuance.

Signed: X Bobby Redmon

Improvement Permit by: A.C. Moore date 6-8-94

Existing System Inspection by: date

Installed by: AAA Enterprises

Certificate of Completion by: A.C. Moore date 10-6-94

Operation Permit by: date

HEALTH DEPT. COPY: WHITE INSPECTION COPY (FINAL): GREEN OWNER COPY (FINAL): YELLOW INSPECTION COPY (INITIAL): PINK OWNER COPY (INITIAL): GOLD