PERMIT DESCRIPTION NO. 18158 DATE 8-8-1988 TAX MAP NO. 10 6 A 0-75 B Water/Well Type
APPLICANT OR CONTRACTOR Bobby Redmon Home 826-3721
ADDRESS Rt 1 Box 287-VB PHONE Business
LOCATION 21 N Port Ebenezer AC Subdivision Rt on left before CC Fray
SUBDIVISION BLOCK / SECTION LOT LOT AREA .8 acres CLASS P.S DESIGN FLOW 360 GPD AR .4

Septic Tank EX 1000 Gallons STB Date 6-2-88
Pump Tank Gallons PT Date
Pump Make Model Serial No
Distribution Field No Fields 1 Square Feet 300 Linear Feet 100
No Lines 2 Trench Width 36" Max Trench Bottom Depth 36" Slope 12" Slab Crawl Space Basement w/plumbing Basement w/o plumbing

New System Repair System Type I II III IV V VI
System Description Addition to EX System
Repair System Description Conv. Gravity
Maintenance Agreement Required Yes No


House/Mod. Home No. Bedrooms 3/5
Mobile Home No. Bathrooms
Business No. Employees
Other

Water Supply: Individual / Community / Public


Comments Adding to EX system 1152/1ed 6-7-88 1000 gal 200' drainline filed under Bobby Redmon
Comments

Existing mobile home must be pulled

INITIAL SITE SKETCH

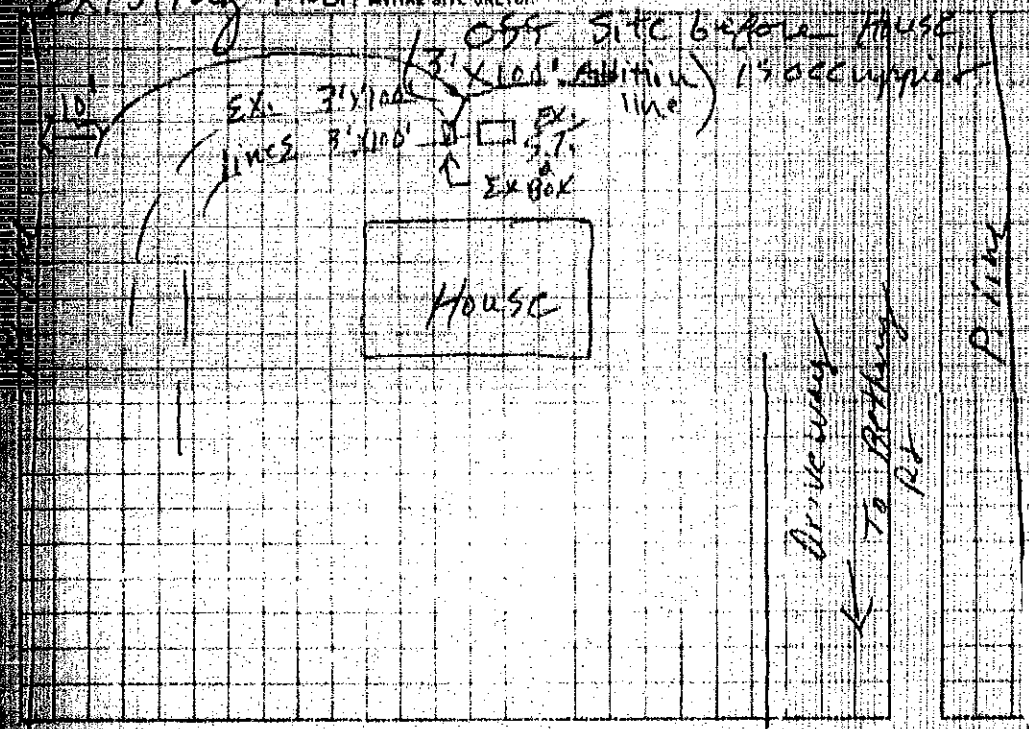

AS BUILT SKETCH

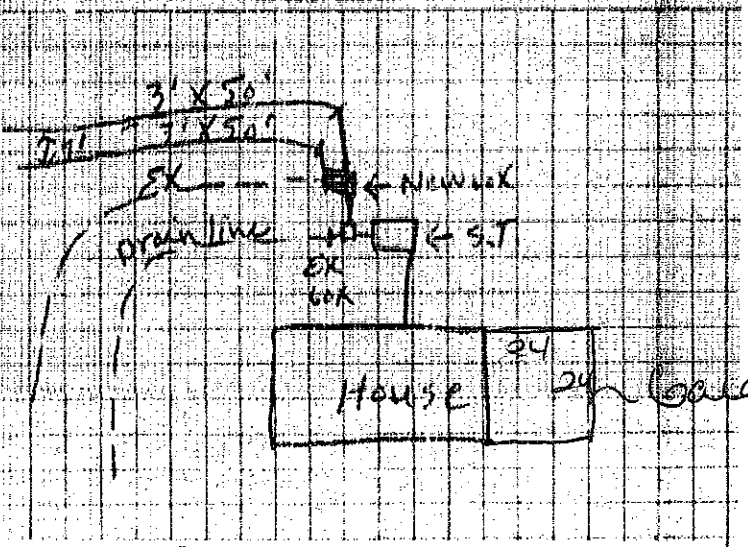

The proposed Garage addition does not appear to impact the existing septic system.
**NOTE:
R.S.
Date: 4/23/09
ICHD-Environmental Health Division

I understand that this permit can be suspended or revoked if any false information is supplied toward securing the permit. Any unauthorized changes are made to the site/any unauthorized changes are made to the installation of the syste
Improvement Permit is valid for 60 months from date of issuance

Signed Bobby Redmon Installed by A.A.A Enterprises
Improvement Permit by R. C. Moore date 6-8-88 Certificate of Completion by R. C. Moore date 10-6
Existing Permit by date Operation Permit by

JAN. 4, 1989 4:09 garage