IREDELL COUNTY HEALTH DEPARTMENT

Statesville Office (704) 878-5305 Mooresville Office (704) 660-3625

PERMIT # 222365

IMPROVEMENT PERMIT / AUTHORIZATION TO CONSTRUCT / OPERATION PERMIT / EXISTING SYSTEM

PIN # 4757-33-2160

APPLICANT: JEFF BLACK APPLICANT ADDRESS: 1168 TURNERSBURG HWY STATESVILLE

SITE ADDRESS: SAME PHONE: 704-645-1003 ALT. PHONE:

SITE DIRECTIONS: 77 N, TR TURNERSBURG, ON R

SUBDIVISION: SECTION: LOT # LOT AREA: .53 AC DESIGN FLOW: L.T.A.R.: 3

Septic Tank EXISTING (gal) STB Date

Pump Tank (gal) PT Date

Pump Make Model Serial #

Nitrification Fields 1 # Lines 4 Linear Ft: 194T

Trench Width 36" Max. Trench Bottom Depth 36" Gravel Depth

☐ New System ☒ Repair ☐ Expansion System Type: I II (III) IV V VI

System Description:

Repair System Description: 25% REDUCTION

Maintenance Agreement Required: ☐ YES ☒ NO

☒ GRAVITY ☐ PRESSURE

☒ Residence No. Bedrooms

☐ Business No. Persons

☐ Other No. Employees

☐ Slab ☒ Crawl Space


☐ Basement w/plumbing ☐ Basement w/o plumbing

Water Supply: ☐ Private ☒ Public ☐ Community

Comments / Conditions:

SYSTEM DESIGNED UNDER BPJ.
INSTALL AS SHOWN USING AS MUCH 25% REDUCTION MATERIAL AS POSSIBLE. HARD PIPE 30'± UNDER DRIVE

INITIAL SITE SKETCH

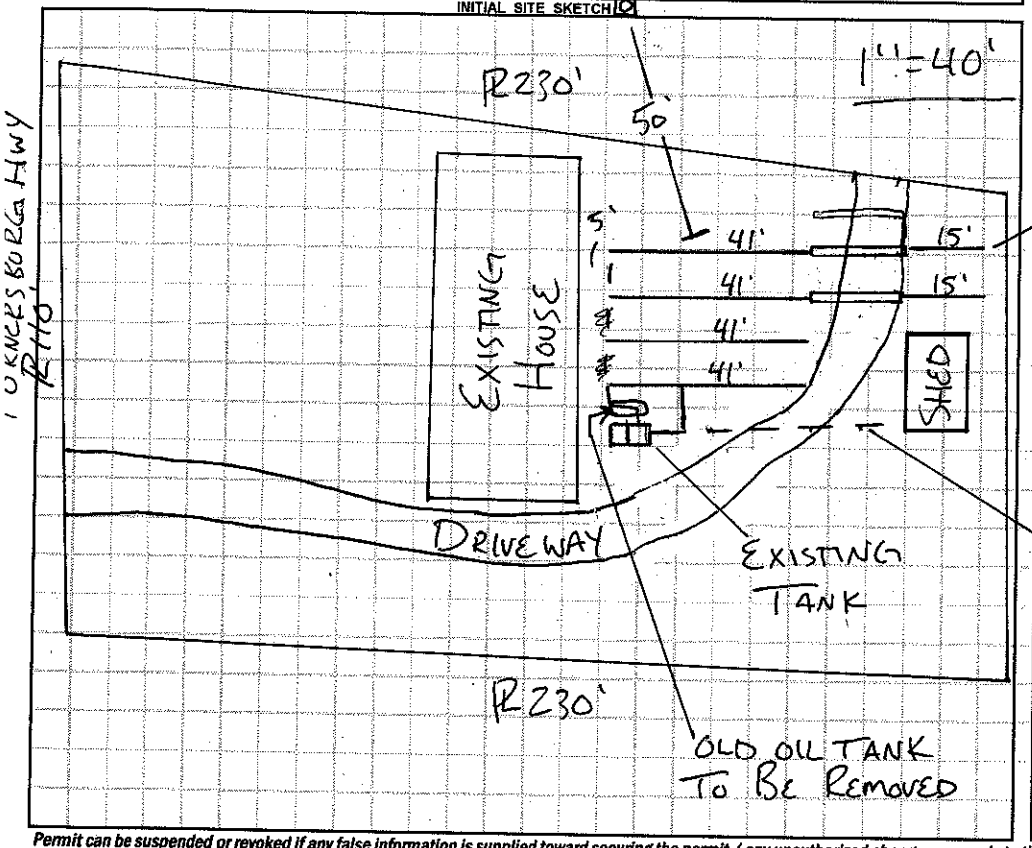

AS BUILT SKETCH

Permit can be suspended or revoked if any false information is supplied toward securing the permit / any unauthorized changes are made to the site / any unauthorized changes are made in the installation of the system. **CONTACT A LOCATOR SERVICE PRIOR TO ANY EXCAVATION**

☐ **IMPROVEMENT PERMIT** *with plat valid without expiration.* ☒ **IMPROVEMENT PERMIT** *with site plan valid for 60 mos.* ☒ **AUTHORIZATION TO CONSTRUCT** *valid for period equal to IMPROVEMENT PERMIT--not to exceed 60 mo.*

Owner / Applicant Signature: Jeffrey Black Date: 10-18-16 Installed by: A-1 Backhoe

IMPROVEMENT PERMIT by: Date: 10-14-16 OPERATION PERMIT by: Date: 10/26/16

AUTHORIZATION TO CONSTRUCT by: Date: 10-14-16 Existing System Inspected by: Date:

Health Dept. Copy - WHITE Applicant (Final Approval) - YELLOW Applicant (Conditional Approval) - PINK