IREDELL COUNTY HEALTH DEPARTMENT - *ENVIRONMENTAL HEALTH* ☒ STATESVILLE OFFICE 704-878-5305 ☐ MOORESVILLE OFFICE 704-664-5281

IMPROVEMENT PERMIT / AUTHORIZATION TO CONSTRUCT / OPERATION PERMIT / EXISTING SYSTEM INSPECTION

PERMIT # Repair PIN # 4757-33-2455 DATE 7-6-11

OWNER Gregg Redmon APPLICANT: Wade Ikard PHONE: Home/Cell # 704 902 9021 Business #

SITE ADDRESS 1179 Turnersburg OWNER / APPLICANT ADDRESS

SITE DIRECTIONS (N) on Hwy 21, on left immediately after Smyre Rd

SUBDIVISION n/a BLOCK / SECTION n/a LOT # n/a LOT AREA .8 Ac DESIGN FLOW 240 L.T.A.R. .15

Septic Tank 1000 Gallons: STB 760 Date 4-11-11

Pump Tank Gallons: P T Date

Pump Make Model Serial #

No. Nitrification Fields: 1 No. Lines 2 Linear Feet 120 Total

Trench Width 36" Max. Trench Bottom Depth 60"

☐ New System ☒ Repair ☐ Expansion System Type I II III IV (V) VI

System Description:

Repair System Description: Deep sand-lined trenches with gravel

Maintenance Agreement Required ☒ YES ☐ NO

Gravel Depth 36" sand 24" gravel ☒ GRAVITY ☐ PRESSURE

☒ Residence No. Bedrooms 2

☐ Business No. Persons

☐ Other No. Employees


☐ Slab ☒ Crawl Space

☐ Basement w/plumbing ☐ Basement w/o plumbing

Water Supply: ☐ Private ☒ Public ☐ Community

Comments / Conditions

INITIAL SITE SKETCH

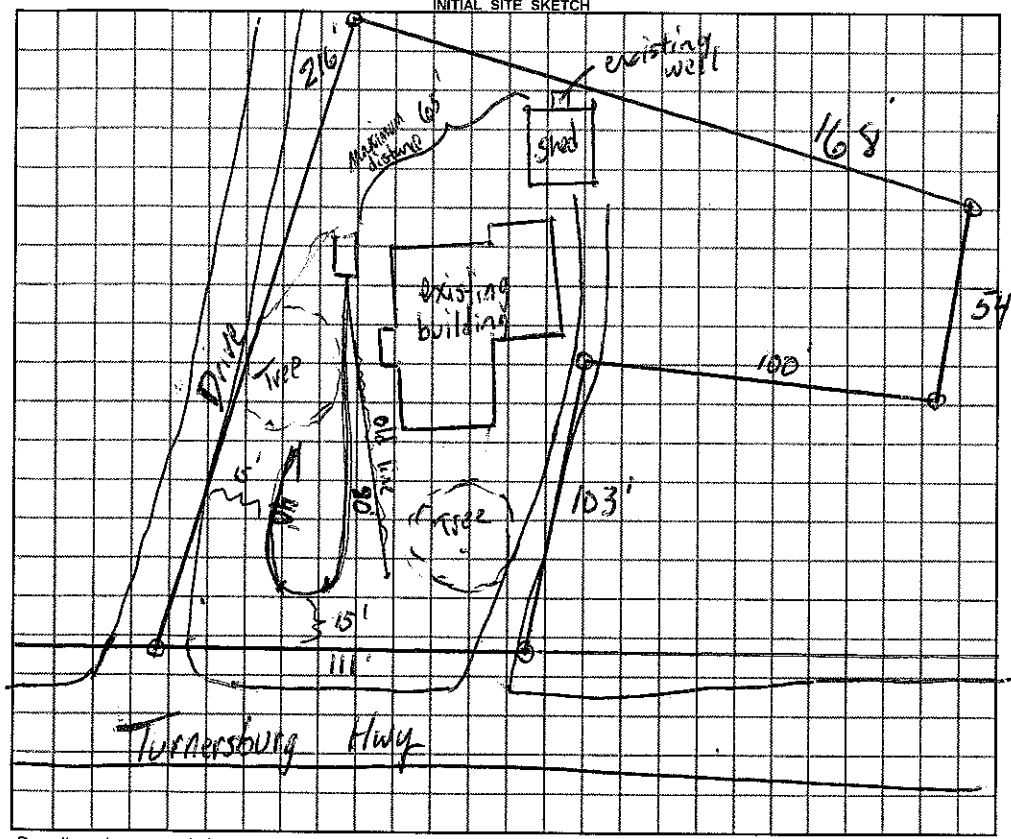

AS BUILT SKETCH

Permit can be suspended or revoked if any false information is supplied toward securing the permit / any unauthorized changes are made to the site / any unauthorized changes are made in the installation of the system.

☐ *IMPROVEMENT PERMIT with plat valid without expiration.* ☐ *IMPROVEMENT PERMIT with plat valid without expiration. site plan valid 60 mo.* ☒ *AUTHORIZATION TO CONSTRUCT* valid for period equal to IMPROVEMENT PERMIT--not to exceed 60 mo.

Owner / Applicant Signature: Date

IMPROVEMENT PERMIT by: REHS Date

AUTHORIZATION TO CONSTRUCT by: REHS Date 7-6-11

YOU SHOULD CONTACT A LOCATOR SERVICE PRIOR TO ANY EXCAVATION

Installed by: A-1 Backhoe

OPERATION PERMIT by: REHS Date 7-13-11

Existing System Inspected by: REHS Date

White Copy – Environmental Health YELLOW COPY (Final) Owner / Applicant PINK COPY (Initial) Owner / Applicant