CCN

ICHD - ENVIRONMENTAL HEALTH DIVISION

Statesville Office (704) 878-5305 | Mooresville Office (704) 660-3625 | PERMIT # 306389

SEPTIC: IMPROVEMENT PERMIT / AUTHORIZATION TO CONSTRUCT / OPERATION PERMIT / EXISTING SYSTEM

PIN # 4757332760.113

APPLICANT/OWNER: Gregg Redmon | APPLICANT ADDRESS: 113 Bethany Rd Statesville NC 28625

SITE ADDRESS: 113 Bethany Rd Statesville NC 28625 | PHONE: 646-512-1620 | ALT. PHONE

SITE DIRECTIONS: Hwy 21 N Left on Bethany Rd First Home on Left | SAP CONTROLLED: ☐ YES ☐ NO


SUBDIVISION: - | SECTION: - | LOT # - | LOT AREA: 3.91 Ave | DESIGN FLOW: Existing | L.T.A.R.: Existing

Septic Tank	1000 (gal)	STB	760	Date	9-14-19	☐ New System ☒ Repair ☐ Expansion	System Type: I II III IV V VI	☒ Residence	No. Bedrooms: Existing
Pump Tank	(gal)	PT		Date		System Description: -		☐ Business	No. Persons: Existing
Pump Make		Model		Serial #		Repair System Description: Tank		☐ Other	No. Employees:
# Nitrification Fields	X	# Lines		Linear Ft:	Existing	Maintenance Agreement Required: ☐ YES ☒ NO		☐ Slab	☐ Crawl Space
Trench Width		Trench Bottom Depth(Low side)		Gravel Depth	-	☐ GRAVITY ☒ PRESSURE		☒ Basement w/plumbing	☐ Basement w/o plumbing


Water Supply: ☐ Private ☑ Public ☐ Community

Comments / Conditions: Pump Crush and fill old tank.

INITIAL SITE SKETCH

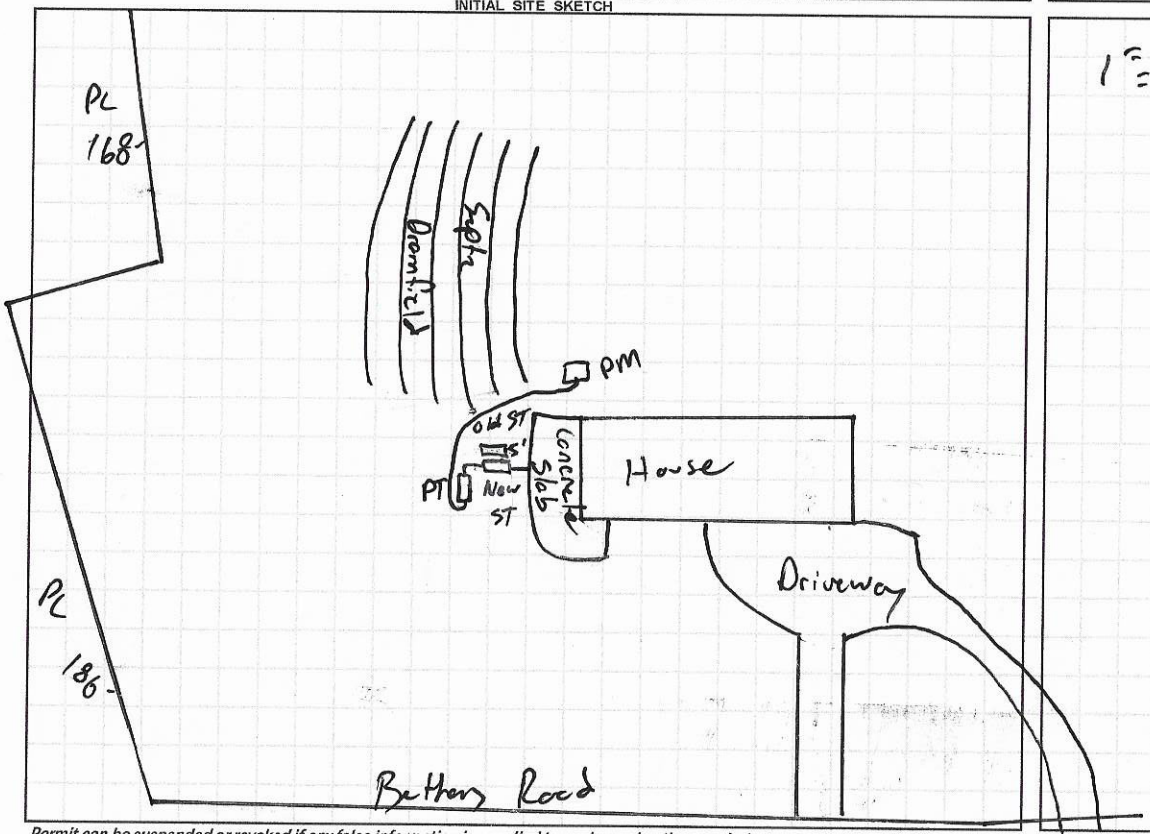

AS BUILT SKETCH

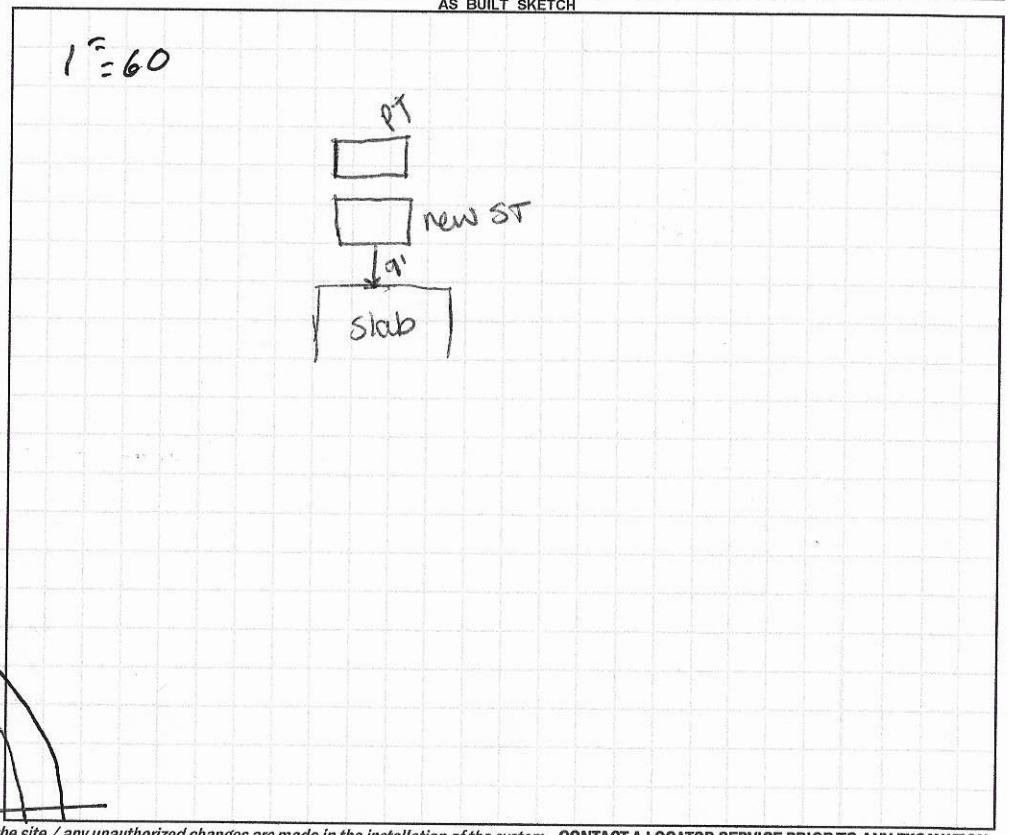

Permit can be suspended or revoked if any false information is supplied toward securing the permit / any unauthorized changes are made to the site / any unauthorized changes are made in the installation of the system. **CONTACT A LOCATOR SERVICE PRIOR TO ANY EXCAVATION**

☐ **IMPROVEMENT PERMIT** *with plat valid without expiration.* ☑ **IMPROVEMENT PERMIT** *with site plan valid for 60 mos.* ☑ **AUTHORIZATION TO CONSTRUCT** *valid for period equal to IMPROVEMENT PERMIT--not to exceed 60 mo.*

Owner / Applicant Signature: Acceptance of Permit Recd | Date: 4-2-2020 | Installed by: Lentz Wastewater

IMPROVEMENT PERMIT by: [signature] | Date: 3-31-2020 | OPERATION PERMIT by: Carla C. Nicks | Date: 4-8-20

AUTHORIZATION TO CONSTRUCT by: [signature] | Date: 3-31-2020 | Existing System Inspected by: | Date:

FOR SEPTIC FINAL INSPECTION: CALL 704-664-3703 between 8am-9am the day the inspection is needed. Be sure to speak with an inpsector to confirm your inspection time.

IREDELL COUNTY HEALTH DEPARTMENT
JANE HINSON, RN BSN MS
HEALTH DIRECTOR

Public Health
Prevent. Promote. Protect.
Iredell County Health Department

ACKNOWLEDGEMENT OF ACCEPTANCE OF PERMIT DESIGN AND CONDITIONS

Any permit requiring a signature must have this form signed by the property owner or their authorized agent. Once this form is signed and returned to Environmental Health an official copy of the permit will be emailed to the email that you provide.

I, Gregg Redmon, am the legal owner or the agent of the property located at 113 Bethany Rd Statesville NC. 28625 identified as PIN(Parcel Identification Number) 4757332260, located in Iredell County, North Carolina.
Permit # 306389.

I do hereby agree to the permit design and the conditions of this permit.

Signature of Owner — Date 4-1-2020

Wade A. Allred — 4-01-2020
Signature of Witness — Date

Raider280@aol.com
email

Central Office (Health Dept.)
318 Turnersburg Hwy
Statesville, NC 28625
704 878-5300

Mooresville – Environmental Health
610 E. Center Avenue
Mooresville, NC 28115
704 660-3625

Statesville - Environmental Health
349 N. Center Street
Statesville, NC 28677
704 878-5305 x3456

http://www.co.iredell.nc.us/Departments/Health/

RECEIVED MAR 3 0 2020

APPLICATION MUST BE FILLED OUT COMPLETELY & BE LEGIBLE OR IT WILL NOT BE PROCESSED

Repair Evaluation - No chg

Iredell County Health Department – Environmental Health Division

PAGE 1: *APPLICATION FORM*

AP-306389

Application For: ( ) New Well Permit ( ) Well Repair Permit ( ) Well Abandonment
( ) Septic Improvement Permit ( ) Authorization to Construct ( ) Existing System Inspection (✓) Septic System Repair

THE ABOVE PERMIT DOCUMENTS WILL BECOME INVALID IF INFORMATION PROVIDED ON THIS APPLICATION IS FALSIFIED OR CHANGED, OR IF THE SITE IS ALTERED. THE IMPROVEMENT PERMIT IS VALID FOR EITHER 60 MONTHS OR WITHOUT EXPIRATION DEPENDING UPON DOCUMENTATION SUBMITTED. APPLICATION WITH SITE PLAN 60 MONTHS, APPLICATION WITH COMPLETE, SCALED PLAT WITHOUT EXPIRATION. SEE 15A NCAC 18A .1937(f) FOR DETAILS.

Page 2: *Site Plan Worksheet* form MUST accompany this application

The following optional attachments may also be submitted: ( ) Survey Plat, scaled no more than 1 inch = 60 feet
Place an (X) beside whichever is submitted if applicable ( ) Custom Site Plan, scaled no more than 1 inch = 60 feet

Applicant Information: (PRINT CLEARLY)

Applicant Name: Gregg Redmon Address: 138 Central Ave. Jersey City NJ Zip: 07306
Applicant Email: _____ Phone: 646-567-1420 Alt. Phone: _____
Owner Name: _____ Address: _____ Zip: _____
Owner Email: _____ Phone: _____ Alt. Phone: _____

Property Information:

Street Address: 113 Bethany Rd. Statesville N.C 28625
Subdivision Name: _____ Section/Phase: _____ Lot Number: _____
Driving Directions: _____

Site Development Information: *(check or complete ALL that apply*

( ) New Single Family Residence
( ) New Multi-Family Residence
( ) Accessory Building
( ) Bedroom(s) Addition
(✓) Repair to failing septic system ✓ Tank ___ Drain lines Describe Problem: _____

Maximum Number of Bedrooms: 3
Maximum Number of Occupants: 5
( ) Swimming Pool
( ) Other Addition/Structure: _____

CHECK FOUNDATION TYPE

( ) Crawl Space Foundation
( ) Concrete Slab Foundation
(✓) Basement with Plumbing
( ) Basement without Plumbing

Non-Residential Site Development: Type of Business: _____
Square Footage of Building: _____ Max. Number of Employees: _____ Max. Number of Seats/Beds/Other: _____

Water Supply: ( ) Replacement Well – Reason: _____
( ) Multi-connection Well Number of Houses: _____ Number of Persons: _____

( ) New Well (✓) Existing Well ( ) Community Well ( ) City Water ( ) Other Public Water

Desired Septic System Type: *(you may rank in order of preference)* Year existing system installed: _____
( ) No Preference ( ) Alternative ( ) Conventional ( ) Innovative ( ) Modified Conventional ( ) Other: _____

Please answer the following to the best of your ability:

( ) Yes (✓) No Does the site contain any jurisdictional wetlands?
( ) Yes (✓) No Is any non-domestic sewage (i.e. industrial) to be generated?
( ) Yes (✓) No Is the site subject to approval by any other public agency?

I have read this application and certify that the information provided herein is true, complete, and correct. Authorized county and state officials are granted right of entry to conduct necessary inspections to determine compliance with applicable laws and rules. I understand that I am solely responsible for the proper identification and labeling of all property lines and corners and making the site accessible so that a complete site evaluation can be performed.


Signature: Gregg Redmon 3-24-2020
Property owner or owner's legal representative signature (SIGNATURE REQUIRED) DATE

IREDELL COUNTY HEALTH DEPARTMENT

ENVIRONMENTAL HEALTH DIVISION

PAGE 2: *SITE PLAN WORKSHEET*

SEE THE "SAMPLE SITE PLAN" BELOW. ***INCOMPLETE SITE PLANS WILL BE RETURNED TO YOU FOR COMPLETION AND MAY RESULT IN A DELAY IN THE ISSUANCE OF YOUR SEPTIC SYSTEM PERMIT!!!***

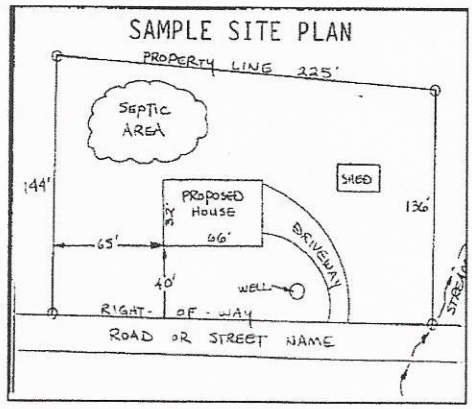

Place an (X) beside each item as you complete the site plan:

- (✓) Property Line measurements are clearly identified
- (✓) All proposed structures are indicated
- (✓) Front and side setbacks from property line
- (✓) Preferred driveway location and well location
- ( ) Area you prefer your septic system to be placed
- ( ) North arrow, or other sufficient indicator of direction

Circle N/A on the following if appropriate:


Location of septic systems and wells within 100' of your property	N/A
Location of easements and rights of ways on your property	N/A
Location of any designated wetlands on the property	N/A

USE THIS SPACE TO DRAW YOUR SITE PLAN

Show: proposed house or business footprint, wells, water lines, patios, pools and decks, and any other item that will occupy space on the site

- See ~~above~~ below

All ready dug up by Lentz company to do repairs.

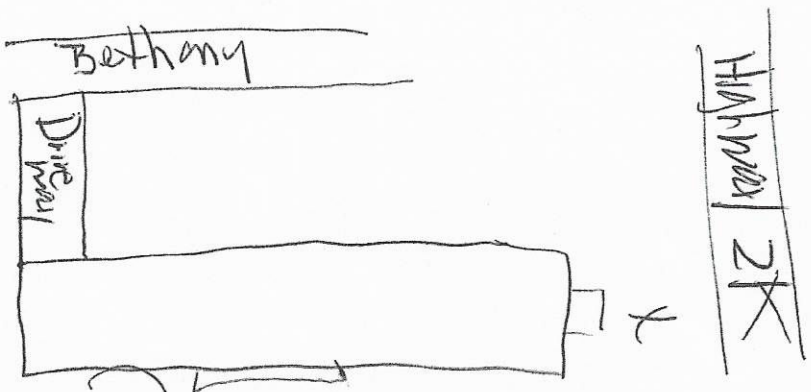

Signature: Mary Redmon

Property owner or owner's legal representative signature (SIGNATURE REQUIRED)

3-27-2020

DATE

1:00

IREDELL COUNTY HEALTH DEPARTMENT

STATESVILLE 704-878-5305 MOORESVILLE 704-664-5281

IMPROVEMENT PERMIT / AUTHORIZATION TO CONSTRUCT / OPERATION PERMIT / EXISTING SYSTEM INSPECTION

PERMIT # Repair PIN # 4757-33-2760 DATE 3-10-10

OWNER or APPLICANT Greg Redmon

OWNER or APPLICANT ADDRESS 113 Bethany Rd Statesville PHONE: Business.. Home: 704-902-9021

LOCATION / DIRECTIONS 21W (R) Bethany 1st drive on left

SUBDIVISION BLOCK / SECTION LOT # LOT AREA 391 DESIGN FLOW 480 L.T.A.R. .25

Septic Tank Exist Gallons: STB [illegible] Date

Pump Tank 1000 Gallons: PT 363 Date 9-30-10

Pump Make Weosh Model Gould Serial # [illegible]

Nitrification Field No Fields 1 No Lines 6 Linear Feet 480

Trench Width 36" Max. Trench Bottom Depth 24 Gravel Depth NA

☐ New System ☑ Repair ☐ Expansion System Type I II (III) IV V VI

System Description:

Repair System Description: 2590 pump PM

Maintenance Agreement Required ☐ YES ☑ NO

☐ GRAVITY ☑ PRESSURE


☑ Residence No. Bedrooms 4
☐ Business No. Persons
☐ Other No. Employees
☐ Slab ☐ Crawl Space
☑ Basement w/plumbing ☐ Basement w/o plumbing

Water Supply
☐ Private
☑ Public
☐ Community

Comments / Conditions

Comments / Conditions 20"-24" Trench Bottom

INITIAL SITE SKETCH

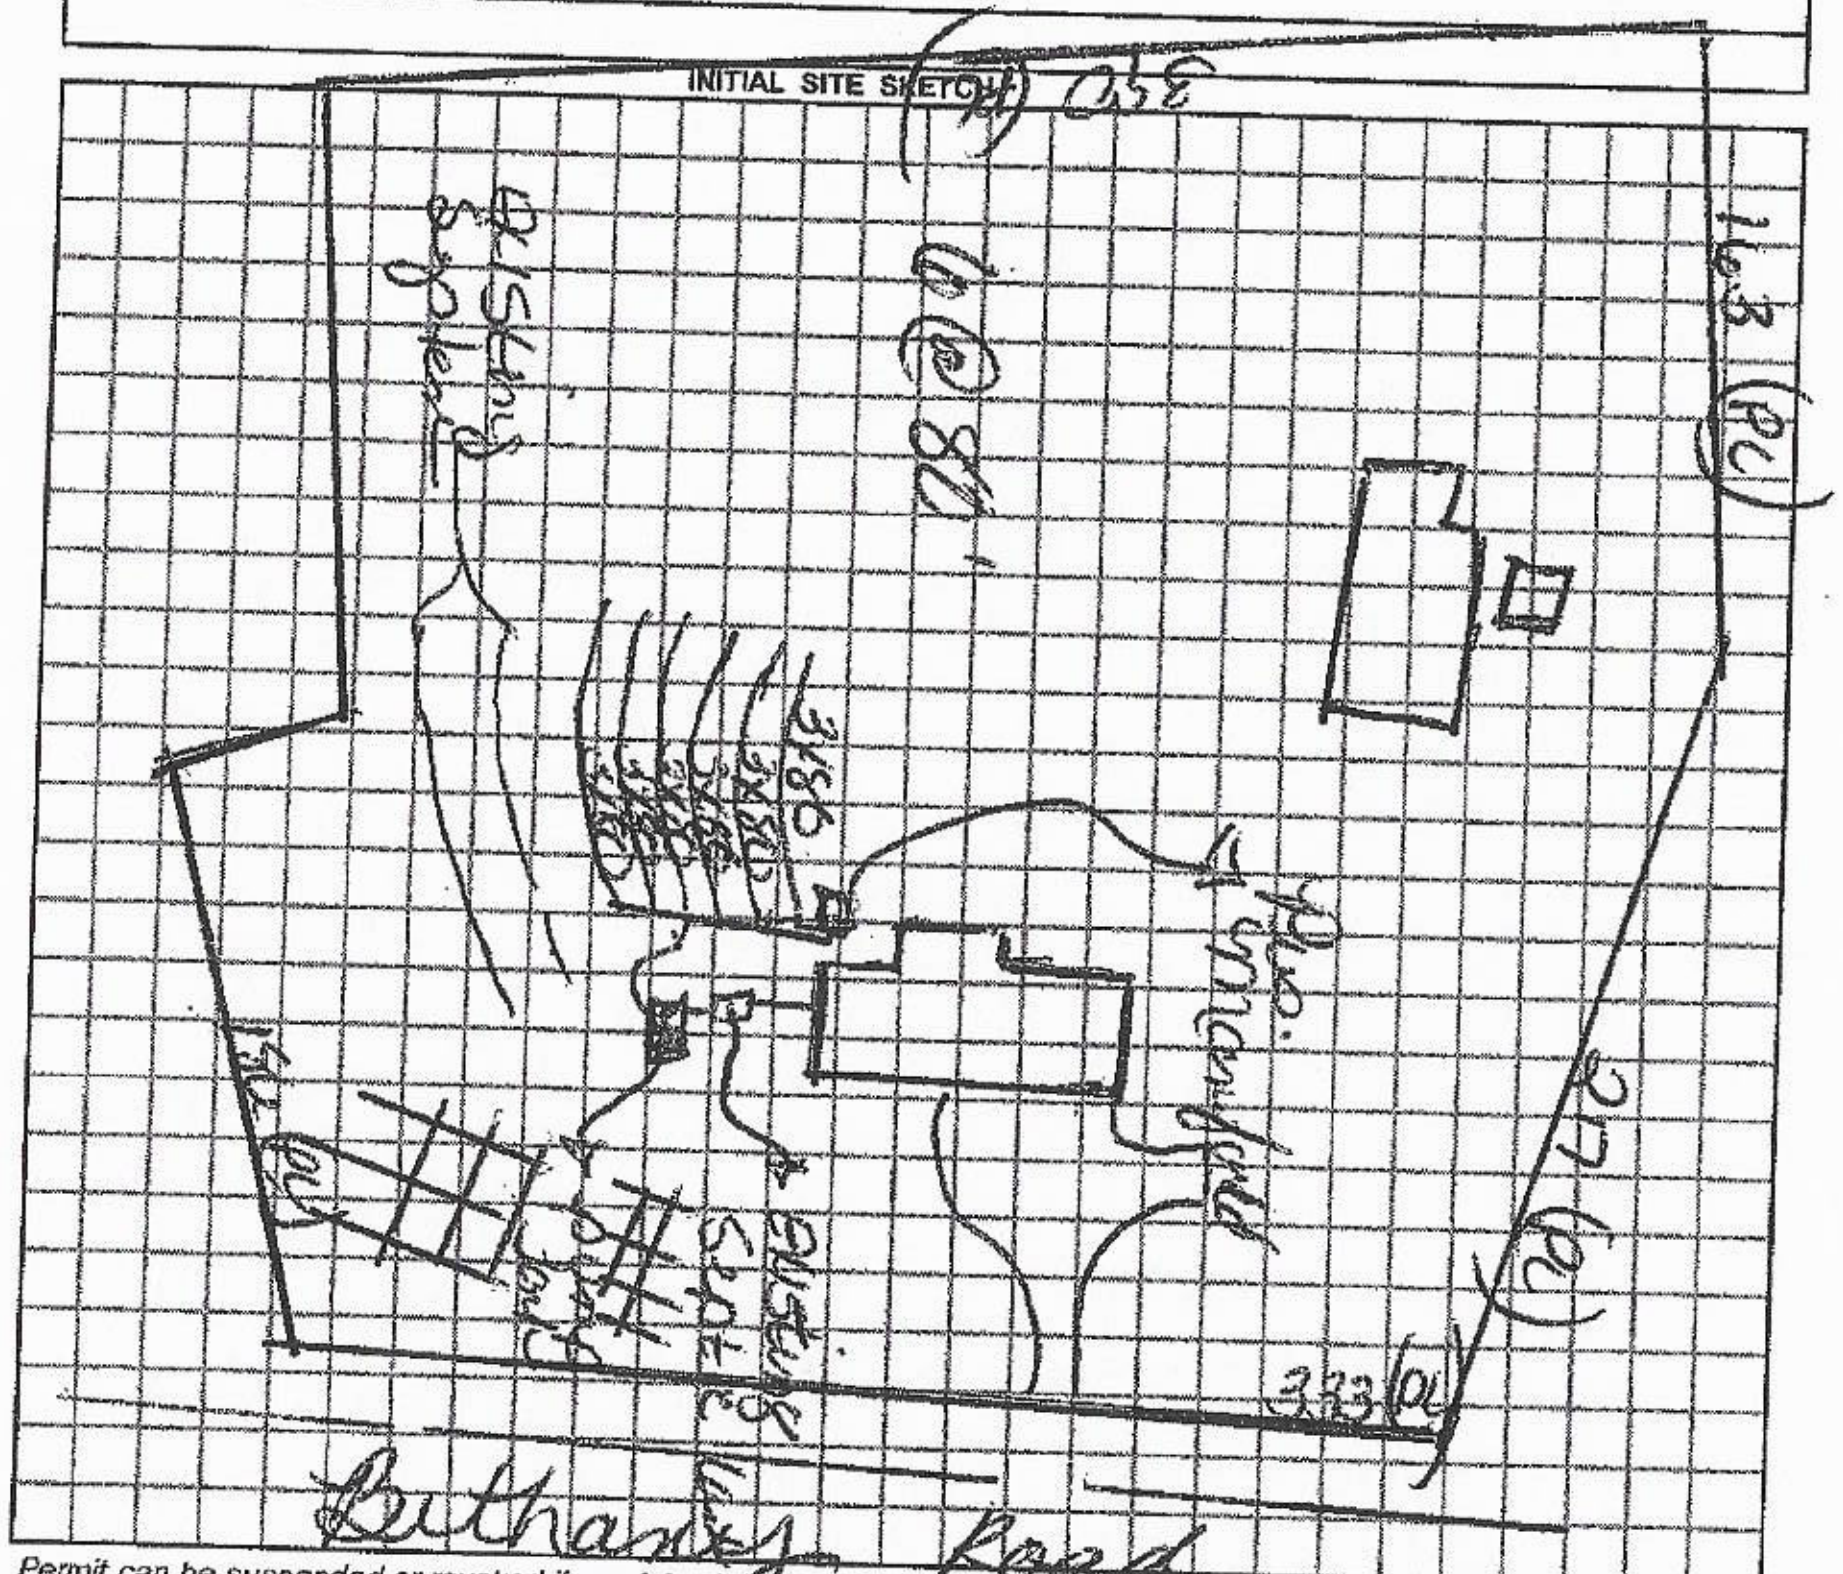

AS BUILT SKETCH

Permit can be suspended or revoked if any false information is supplied toward securing the permit / any unauthorized changes are made to the site / any unauthorized changes are made in the installation of the system.

☐ IMPROVEMENT PERMIT w / plat valid without expiration. ☑ IMPROVEMENT PERMIT w / site plan valid for 60 mos. ☑ AUTHORIZATION TO CONSTRUCT valid for period equal to IMPROVEMENT PERMIT-not to exceed 60 mo.

Owner / Applicant Signature: Dennis Gallihan Date 3-10-10

Improvement Permit by: [signature] Date 3-10-10

Authorzation to Construct by: [signature] Date 3-10-10

YOU SHOULD CONTACT A LOCATOR SERVICE PRIOR TO ANY EXCAVATION.

Installed by: [signature]

Operation Permit By: [signature] Date: 3-10-10

Existing System Inspected by: Date:

WHITE COPY Environmental Health YELLOW COPY (Final) Owner / Applicant PINK COPY (Initial) Owner / Applicant

IREDELL COUNTY DEPARTMENT OF ENVIRONMENTAL HEALTH

DOCUMENTATION TO AUTHORIZE AN OWNER'S LEGAL REPRESENTATIVE

(Check and sign only ONE of the options below)

☑ 1. * APPLICANT AND OWNER ARE THE SAME. * (*Sign here*) [signature]

Applications for permits require the "signature of the owner or owner's legal representative" (15A NCAC 18A .1937). If the owner does not sign the application himself or herself, they can submit any one of the following documents to designate their legal representative: *Power of Attorney; Real Estate Contract; Estate executor; Bankruptcy trustee; Court ordered guardianship*
In the absence of the above documentation, the property owner may provide the local health department with documentation that designates a legal representative. A property owner may:
Complete this form to document his or her legal representative, or provide his or her own form that contains the information in this form. If there are multiple property owners, then all property owners must sign the form that designates a legal representative.
By signing a form that designates a legal representative for purposes of 15A NCAC 18A .1937, the property owner authorizes that representative to act on their behalf in matters pertaining to the application and permitting process, including signing or receiving any application, document or permit. The owner retains full responsibility to meet all permit conditions specified by the local health department.

☐ **2.** I, _____, am the legal owner(s) of the property located at _____, identified as PIN (Parcel Identification Number)_____, located in Iredell County, North Carolina.

I do hereby authorize (**print legal representative/company name**) _____, _____, to act as an agent on my behalf in applying for/signing/obtaining any of the documents described below.

- Application for Improvement Permit (IP) / Authorization to Construct (AC)
- Improvement Permit (IP) / Authorization to Construct (AC)
- Application for soil-site evaluation (new/repair)
- Application/permit for private drinking water well/well abandonment
- Application for Compliance Inspection

I agree to abide by all decisions and/or conditions between the legal representative acting on my behalf and the Iredell County Department of Public Health, Environmental Health Division.

[signature] _____ 3-29-2020
Signature of Owner(s) Date

Mooresville - Environmental Health
Fax: 704-662-3239
610 E. Center Avenue, Mooresville, NC 28115

Statesville - Environmental Health
ronda.hart@co.iredell.nc.us
Fax: 704-871-3483
349 N. Center Street, Statesville, NC 28677