1:00

IREDELL COUNTY HEALTH DEPARTMENT

STATESVILLE 704-878-5305   MOORESVILLE 704-664-5281

IMPROVEMENT PERMIT / AUTHORIZATION TO CONSTRUCT / OPERATION PERMIT / EXISTING SYSTEM INSPECTION

PERMIT # Repair   PIN # 4757-33-2760   DATE 3-10-10

OWNER or APPLICANT Greg Redmon

OWNER or APPLICANT ADDRESS 113 Bethany RD Statesville   PHONE: Business   Home: 704-902-9021

LOCATION / DIRECTIONS 21W (R) Bethany 1st drive on left

SUBDIVISION   BLOCK / SECTION   LOT #   LOT AREA 391   DESIGN FLOW 480   L.T.A.R. .25

Septic Tank EXIST   Gallons: STB 1000   Date

Pump Tank 1000   Gallons: PT 363   Date 9-20-10

Pump Make WEOSTH   Model Goulds   Serial # JPWE0571

Nitrification Field No Fields 1   No Lines 6   Linear Feet 480

Trench Width 36"   Max. Trench Bottom Depth 24   Gravel Depth NA   ☐ GRAVITY   ☑ PRESSURE

☐ New System ☑ Repair ☐ Expansion System   Type I II (III B) IV V VI

System Description:

Repair System Description: 2590 pump PM

Maintenance Agreement Required ☐ YES ☑ NO

☑ Residence   No. Bedrooms 4

☐ Business   No. Persons

☐ Other   No. Employees

☐ Slab   ☐ Crawl Space

☑ Basement w/plumbing   ☐ Basement w/o plumbing


Water Supply: ☐ Private ☑ Public ☐ Community

Comments / Conditions

Comments / Conditions

20"-24" Trench Bottom

INITIAL SITE SKETCH

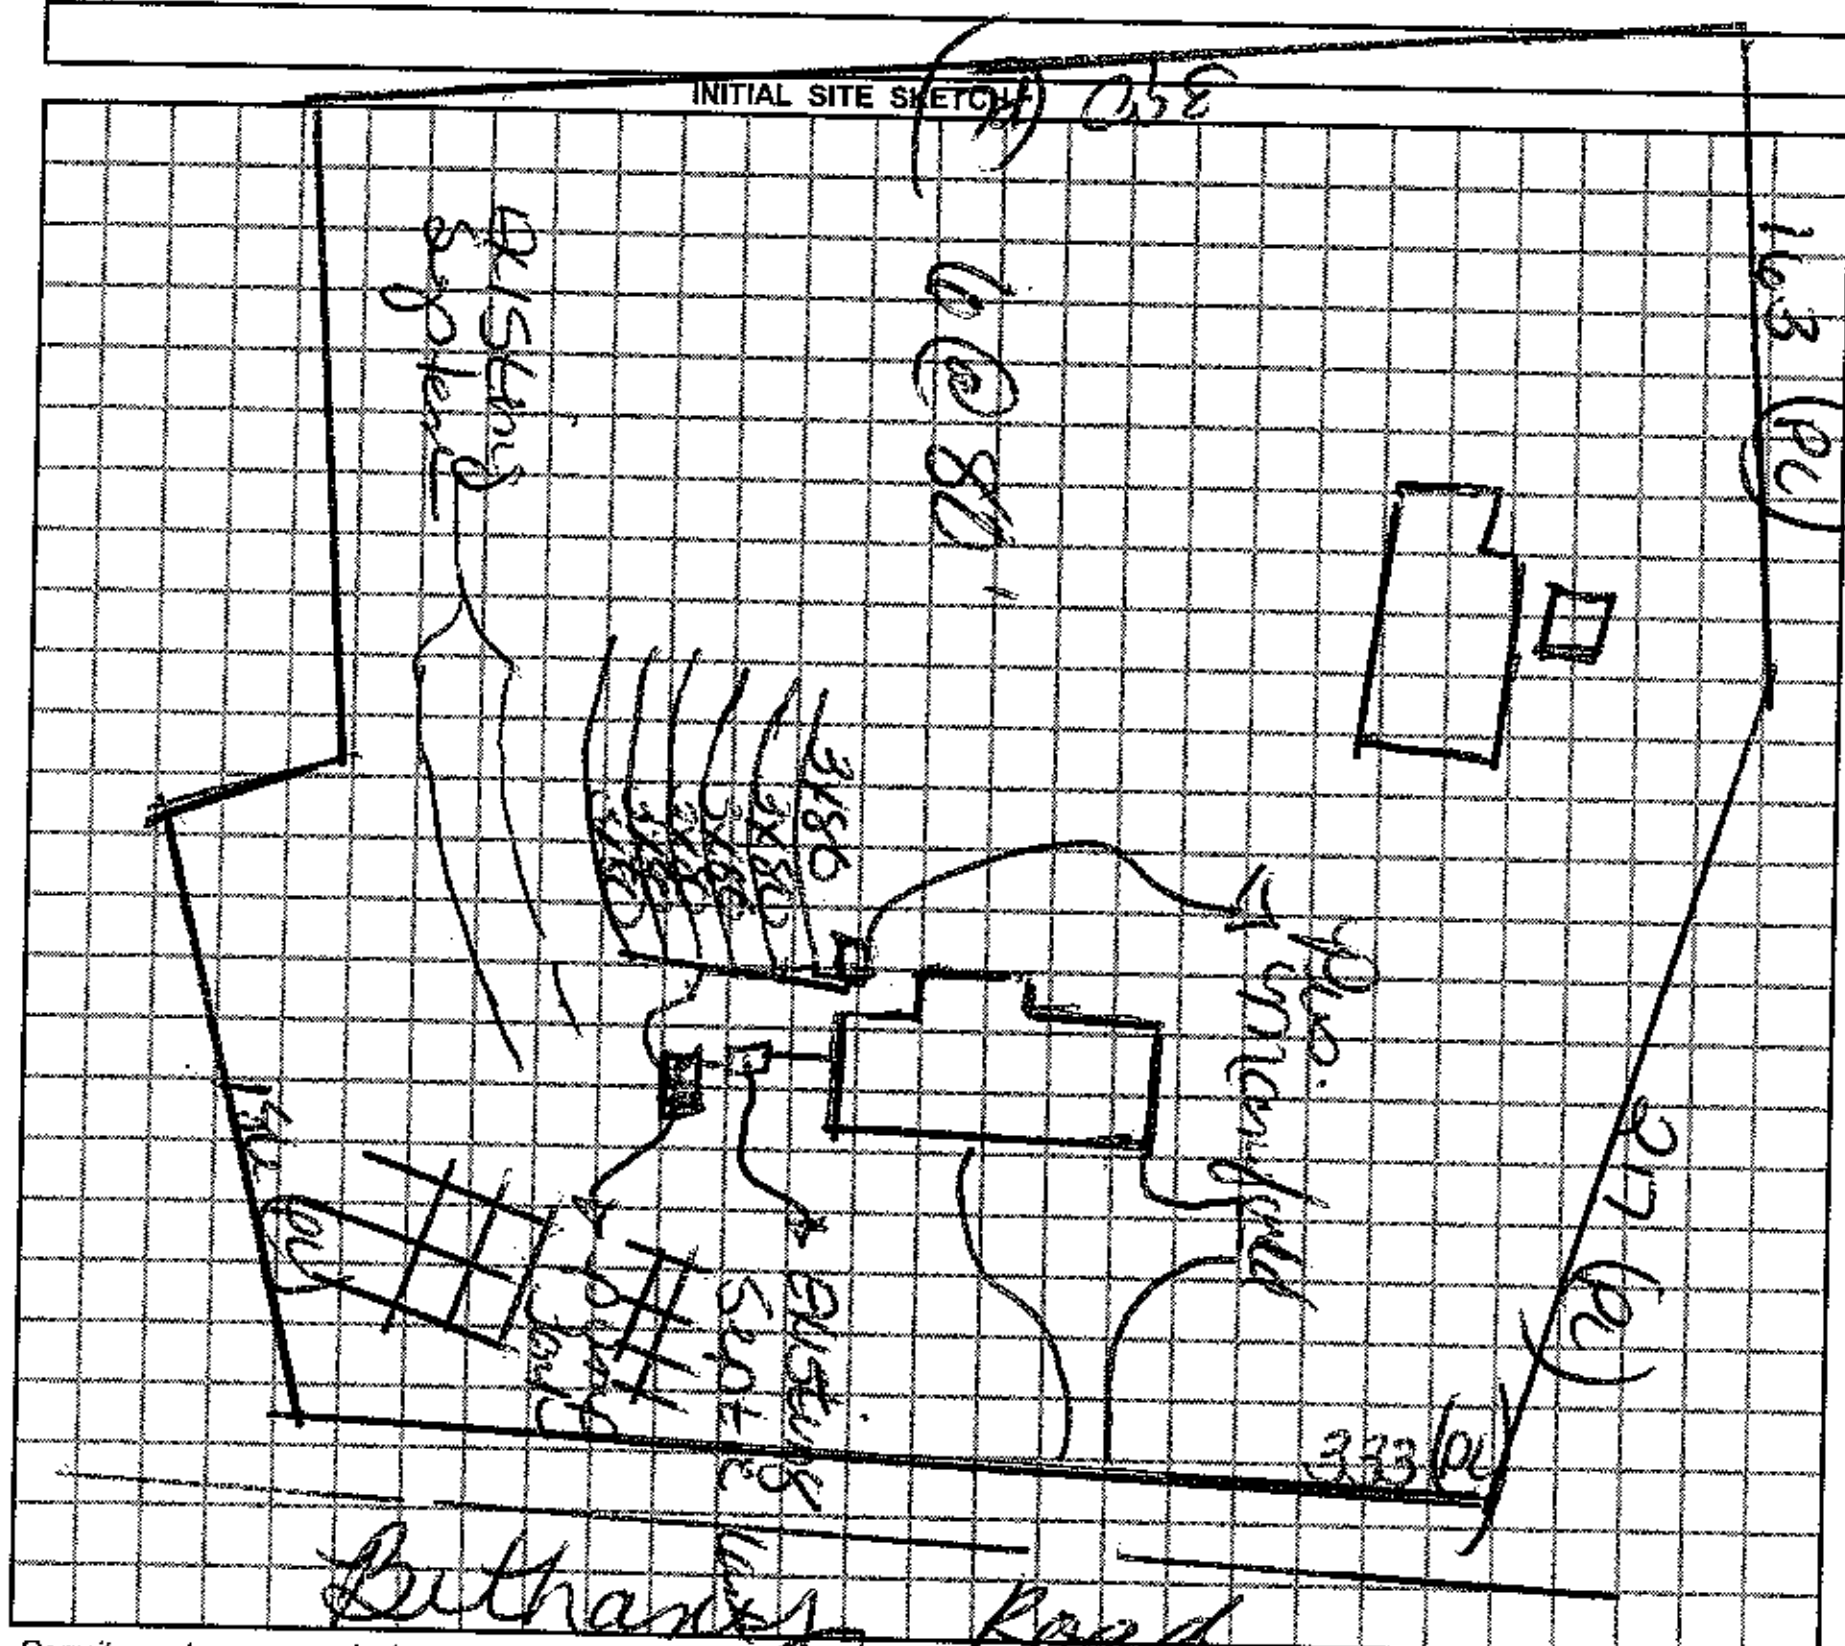

AS BUILT SKETCH

Permit can be suspended or revoked if any false information is supplied toward securing the permit / any unauthorized changes are made to the site / any unauthorized changes are made in the installation of the system.

☐ *IMPROVEMENT PERMIT w / plat valid without expiration.*   ☑ *IMPROVEMENT PERMIT w / site plan valid for 60 mos.*   ☑ *AUTHORIZATION TO CONSTRUCT valid for period equal to IMPROVEMENT PERMIT-not to exceed 60 mo.*

Owner / Applicant Signature: Dennis Gallaher   Date 3-10-10

Improvement Permit by: Kevin Cook   Date 3-10-10

Authorzation to Construct by: Kevin Cook   Date 3-10-10

Installed by: A J Brethoc

Operation Permit by: Kevin Cook   Date: 3-10-10

Existing System Inspected by: Date:

YOU SHOULD CONTACT A LOCATOR SERVICE PRIOR TO ANY EXCAVATION.

WHITE COPY Environmental Health   YELLOW COPY (Final) Owner / Applicant   PINK COPY (Initial) Owner / Applicant