IREDELL COUNTY HEALTH DEPARTMENT

STATESVILLE 704-878-5305 MOORESVILLE 704-664-5281

IMPROVEMENT PERMIT / AUTHORIZATION TO CONSTRUCT / OPERATION PERMIT / EXISTING SYSTEM INSPECTION

PERMIT# 75152 PIN# 4757352459 P.T. DATE 8-29-98

OWNER OR CONTRACTOR Dixieland Inc. PHONE: Business 828 478 5331 Home

ADDRESS 4474 Lake Dr. Sherrills Ford N.C.

LOCATION 21 N To Bethany Rd. TR Gilead 3rd lot Rt

SUBDIVISION Bethany Trace BLOCK / SECTION LOT 24 LOT AREA .45 acres SITE CLASS P5 DESIGN FLOW 360 L.T.A.R. .3

Septic Tank: 1000 Gallons: STB 825 Date 4-2-99
Pump Tank: Gallons: PT Date
Pump Make: Model Serial No.
Nitrification Field: No Fields 1 Square Feet 1200 Linear Feet 400
No Lines 5 Trench Width 36" Max Trench Bottom Depth 36" Gravel Depth 12"

☒ New System ☐ Repair System Type: ☐ I ☒ III, IV, V, VI
System Description: Conv. Gravity
Repair System Description: ~~Gravity~~ 25% Red. Pump
Maintenance Agreement Required: ☐ Yes ☒ No


☒ House/Mod. Home No. Bedrooms 3
☐ Mobile Home No. Bathrooms 2
☐ Business No. Employees
☐ Other
☐ Slab ☒ Crawl Space ☐ Basement w/plumbing ☐ Basement wo/plumbing

Water Supply: ☐ Individual ☒ Public ☐ Community


Comments:/Conditions:

Comments:/Conditions:
Note: House w/ front entrance garage.
lines changed to 8 lines @ 58ft

INITIAL SITE SKETCH

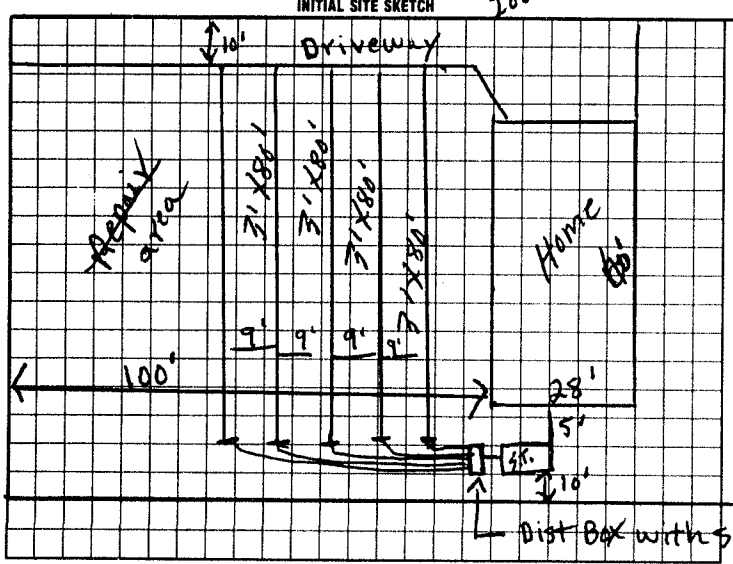

AS BUILT SKETCH

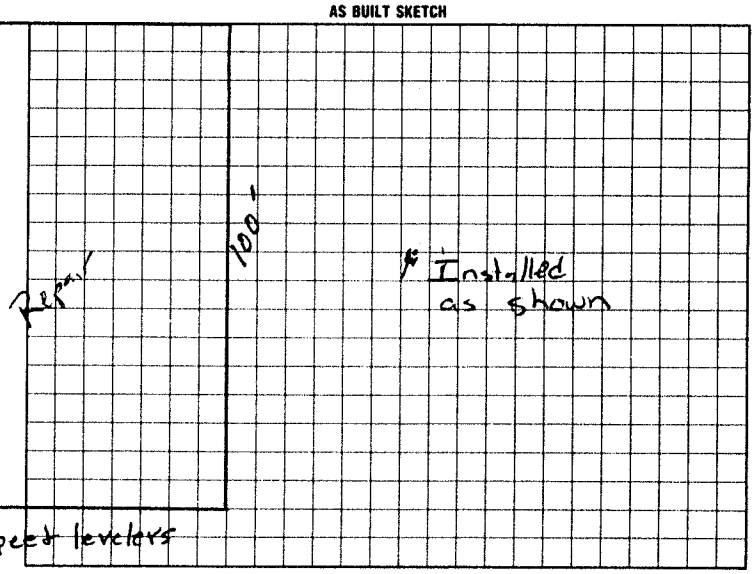

Street

I understand that this permit can be suspended or revoked if any false information is supplied toward securing the permit/any unauthorized changes are made to the site/any unauthorized changes are made in the installation of the system. Improvement Permit with plat valid without expiration. Improvement Permit with site plan valid for sixty months. Authorization to Construct is valid for a period equal to that of Improvement Permit – not to exceed sixty months.

Signed: Regina C Crenshaw date 9/7/98 Installed by: Rowan Septic

Improvement Permit by: R.C. Moore date 8-29-98 Operation Permit by: [illegible] date 6-23-99

Authorization to Construct by: R.C. Moore date 8-29-98 Existing System Inspection by: date

HEALTH DEPT. COPY (WHITE) INSPECTION COPY (FINAL) GREEN OWNER COPY (FINAL) YELLOW INSPECTION COPY (INITIAL) PINK OWNER COPY (INITIAL) GOLD