(300) - (ROWAN SEPTIC)

IREDELL COUNTY HEALTH DEPARTMENT

STATESVILLE 704-878-5305 MOORESVILLE 704-664-5281

IMPROVEMENT PERMIT / AUTHORIZATION TO CONSTRUCT / OPERATION PERMIT / EXISTING SYSTEM INSPECTION

PERMIT# 089350 PIN# 4757352459 (pt.) DATE June 15, 2000

OWNER OR CONTRACTOR Divine Land Inc. // Gaynor Cecil PHONE: Business (704) 202-4971 Home

ADDRESS 4474 Lake Dr. Sherrills Ford N.C.

LOCATION 21 N. to Bethany Rd TR Gilead TR Berea TR Mt Zion on Right at end- 0 SAC

SUBDIVISION Bethany Trace BLOCK / SECTION 2 LOT 28 LOT AREA .56 Ac SITE CLASS PS DESIGN FLOW 360 gpd L.T.A.R. .3

Septic Tank: 1000 Gallons; STB 825 Date 5-11-00

Pump Tank: Gallons; PT Date

Pump Make: Model Serial No.

Nitrification Field: No Fields 1 Square Feet 900 Linear Feet 300

No Lines ~6 Trench Width 36" Trench Bottom Depth 36" Gravel Depth NA

☑ New System ☐ Repair System Type: I. II. III. IV. V.

System Description: GRAVITY INNOVATIVE-25% Red.

Repair System Description: pumped INNOV. / conv.

Maintenance Agreement Required: ☐ Yes ☑ No

☑ House/Mod. Home No. Bedrooms 3

☐ Mobile Home No. Bathrooms 2

☐ Business No. Employees

☐ Other


☐ Slab ☑ Crawl Space ☐ Basement w/plumbing ☐ Basement wo/plumbing

Water Supply: ☐ Individual ☑ Public ☐ Community

Comments/Conditions: Installer Note: All nitrification Laterals to be installed at 36" trench bottom. & ONE inspection port per Lateral, set flush with finished grade.

Comments/Conditions: ① SEPTIC TANK W/ MARKER INSTALLED USING "POLY LOK" FILTER

INITIAL SITE SKETCH

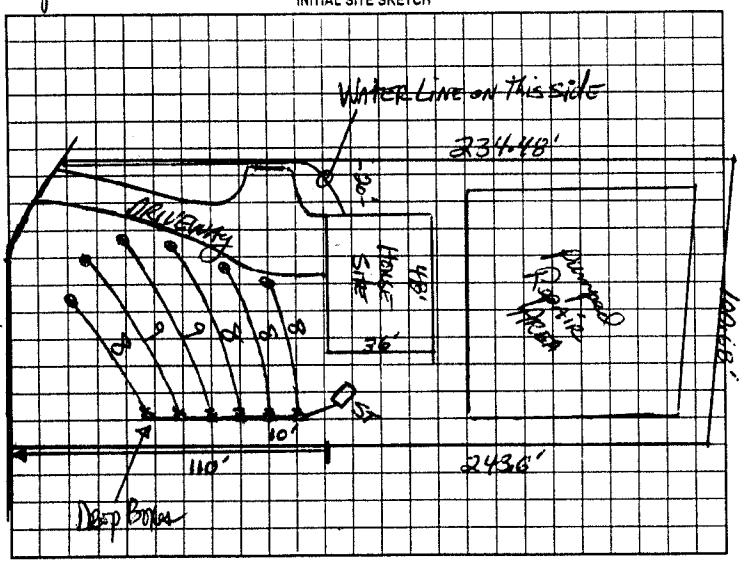

AS BUILT SKETCH

SYSTEM INSTALLED ACCORDING TO INITAL SITE SKETCH USING FIFTY (50) "INFILTRATOR" CHAMBERS AS SHOWN

Permit can be suspended or revoked if any false information is supplied toward securing the permit/any unauthorized changes are made to the site/any unauthorized changes are made in the installation of the system. Improvement Permit with plat valid without expiration. Improvement Permit with site plan valid for sixty months. Authorization to Construct is valid for a period equal to that of Improvement Permit – not to exceed sixty months.

Signed: * Gaynor Cecil - date 6/15/00

Improvement Permit by: [signature], RS date 6-15-00

Authorization to Construct by: [signature], RS date 6-15-00

Installed by: ROWAN SEPTIC TANK SERVICE

Operation Permit by: STEVE HEDRICK date 7-14-2000

Existing System Inspection by: date

HEALTH DEPT COPY WHITE OWNER COPY (FINAL) YELLOW OWNER COPY (INITIAL) PINK