IREDELL COUNTY HEALTH DEPARTMENT

STATESVILLE 704-878-5305 MOORESVILLE 704-664-5281

IMPROVEMENT PERMIT / AUTHORIZATION TO CONSTRUCT / OPERATION PERMIT / EXISTING SYSTEM INSPECTION

PERMIT# 088567 PIN# 4757 35 2459 (PT) DATE 4-15-00

OWNER OR CONTRACTOR DIXIE LAND INC PHONE: Business (828) 478-5381 Home (704) 202-4971 (M)

ADDRESS 4474 LAKE DRIVE, SHERRILLS FORD NC 28673

LOCATION US 21 N, TL BETHANY RD, TR, GILEAD LANE, TR BEREA LANE, TR MT. ZION, 2ND LOT ON RIGHT

SUBDIVISION BETHANY TRACE BLOCK / SECTION II LOT 29 LOT AREA 0.4591 ACRE SITE CLASS PS DESIGN FLOW 360 L.T.A.R. 0.30 GPD/FT²

Septic Tank: 1000 Gallons: STB 825 Date 5-11-00
Pump Tank: ____ Gallons: PT ____ Date ____
Pump Make: ____ Model ____ Serial No. ____
Nitrification Field: No Fields 1 Square Feet 1200 Linear Feet 300+
No Lines EIGHT Trench Width 36" Max Trench Bottom Depth 36" Depth SAND 6"

☑ New System ☐ Repair System Type: I. II (III) IV. V. VI
System Description: 25% REDUCTION GRAVITY
Repair System Description: 25% REDUCTION Pump
Maintenance Agreement Required: ☐ Yes ☑ No
☐ Slab ☑ Crawl Space ☐ Basement w/plumbing ☐ Basement wo/plumbing


☑ House/Mod. Home No. Bedrooms 3
☐ Mobile Home No. Bathrooms 2
☐ Business No. Employees ____
☐ Other ____

Water Supply: ☐ Individual ☑ Public ☐ Community


Comments/Conditions: ① REMOVE EXISTING FIELD TERRACE ② INSTALL 25% REDUCTION SYSTEM USING FIFTY (50) CHAMBERS OR THEM (30) HDS SECTIONS ③ RAKE TRENCH SIDEWALLS AND APPLY A LIGHT DUSTING OF LIME

Comments/Conditions ① SEPTIC TANK W/ MARKER INSTALLED USING "POLYLOK" FILTER ② "INFILTRATOR" CHAMBERS INSTALLED (50)

INITIAL SITE SKETCH

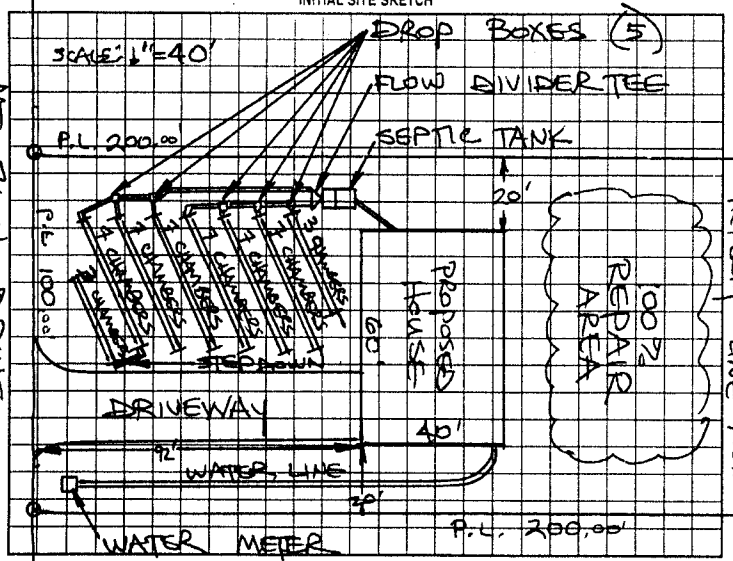

AS BUILT SKETCH

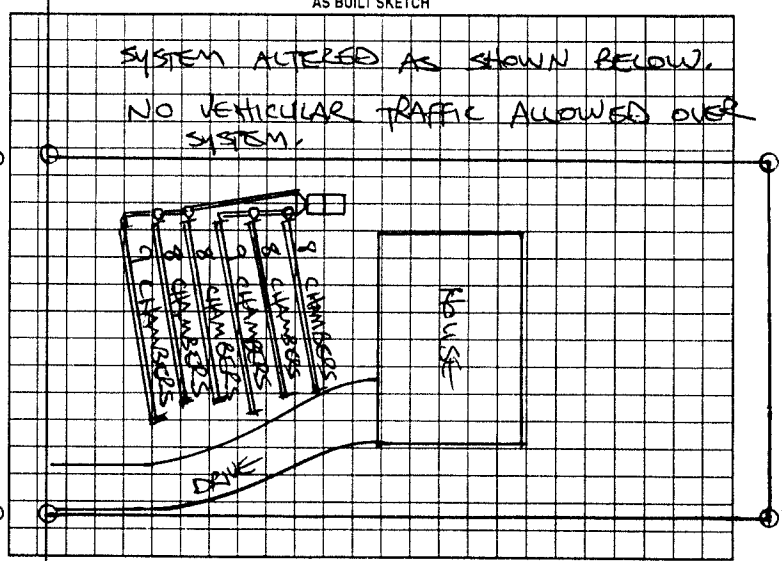

Permit can be suspended or revoked if any false information is supplied toward securing the permit/any unauthorized changes are made to the site/any unauthorized changes are made in the installation of the system. Improvement Permit with plat valid without expiration. Improvement Permit with site plan valid for sixty months. Authorization to Construct is valid for a period equal to that of Improvement Permit – not to exceed sixty months.

Signed: Ginger Cecil date 4/17/00 Installed by: ROWAN SEPTIC TANK SERVICE

Improvement Permit by: STEVE HEDRICK date 4-15-00 Operation Permit by: STEVE HEDRICK date 7-14-2000

Authorization to Construct by: STEVE HEDRICK date 4-15-00 Existing System Inspection by: ____ date ____

HEALTH DEPT. COPY WHITE OWNER COPY (FINAL) YELLOW OWNER COPY (INITIAL) PINK