IREDELL COUNTY HEALTH DEPARTMENT

STATESVILLE 704-878-5305 CI MOORESVILLE 704-664-5281

IMPROVEMENT PERMIT / AUTHORIZATION TO CONSTRUCT / OPERATION PERMIT / EXISTING SYSTEM INSPECTION

PERMIT# 136348 PIN# 4757345650 DATE 7-19-06

OWNER OR APPLICANT Ginger Cecil/Dixieland PHONE: Business 704 202 4971 Home

ADDRESS 102 Mt. Zion Dr.

LOCATION 823 Jennings Rd.

SUBDIVISION Bethany Trace BLOCK / SECTION II LOT 54 LOT AREA .7 SITE CLASS. PS DESIGN FLOW 360 L.T.A.R. .03

Septic Tank: 1000 Gallons: STB 625 Date 3-1-06
Pump Tank: ____ Gallons: PT ____ Date ____
Pump Make: ____ Model ____ Serial No. ____
Nitrification Field: No Fields 1 Square Feet 1200 Linear Feet 300
No Lines 3 Trench Width 36" Max Trench Bottom Depth 36"

☒ New System ☐ Repair ☐ Expansion System Type: I II (III) IV V VI
System Description: 25% Reduction - Gravity
Repair System Description: 25% Reduction Pump
Maintenance Agreement Required: ☐ Yes ☒ No

☒ House/Mod. Home No. Bedrooms 3
☐ Mobile Home No. Persons ____
☐ Business No. Employees ____
☐ Other ____


Water Supply: ☒ Individual ☐ Public ☐ Community

Gravel Depth n/a ☒ Gravity ☐ Pressure ☐ Slab ☒ Crawl Space ☐ Basement w/plumbing ☐ Basement wo/plumbing


Comments:/Conditions:

Comments:/Conditions:
Blue Tuf-Tite filter
no risers
no S/T marker

INITIAL SITE SKETCH

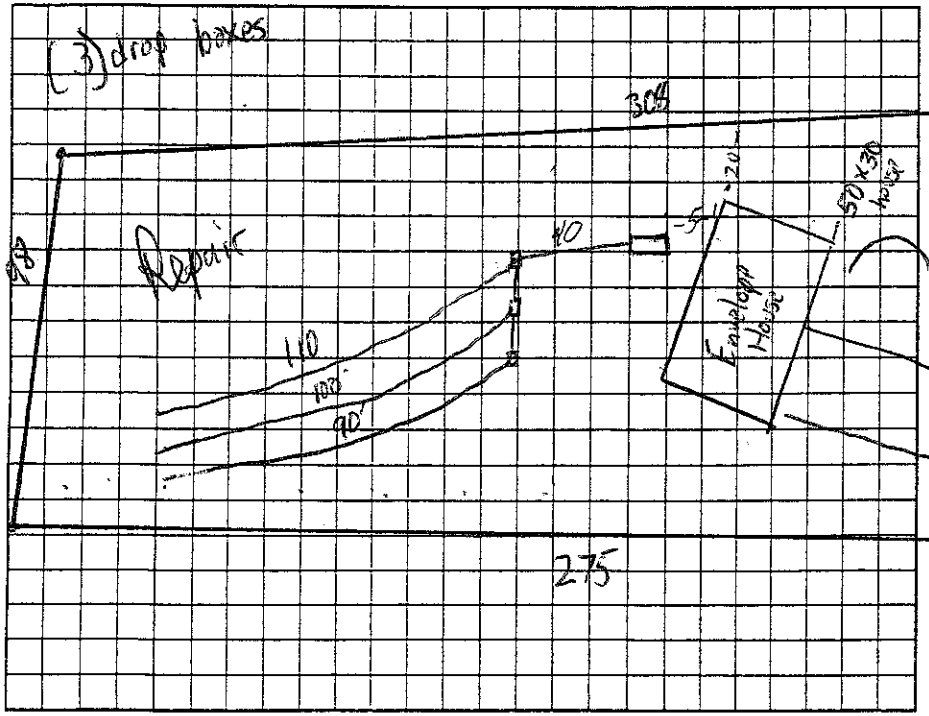

AS BUILT SKETCH

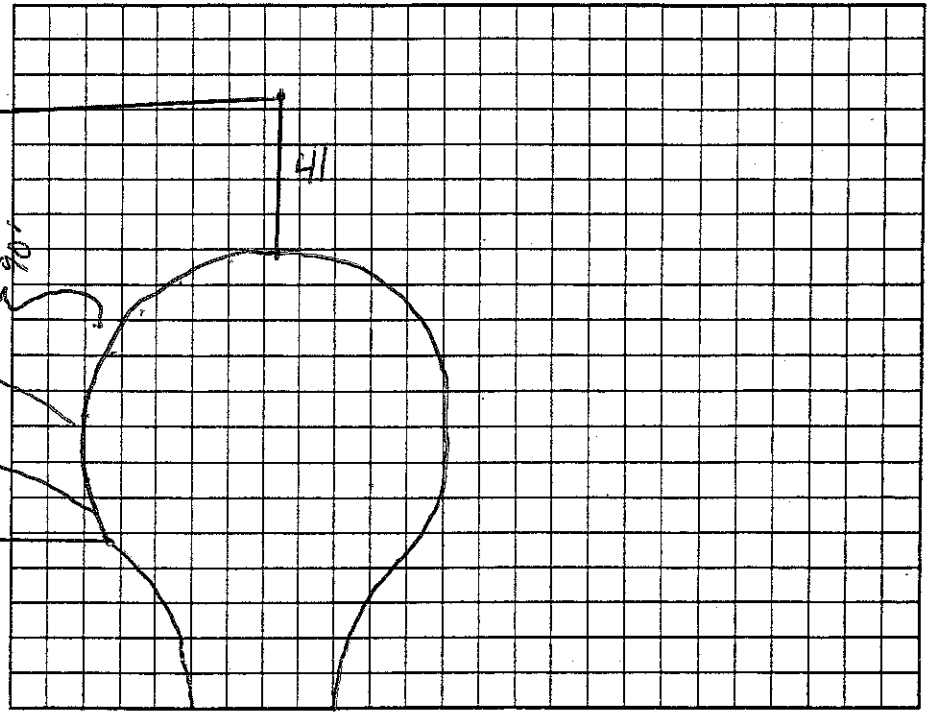

Permit can be suspended or revoked if any false information is supplied toward securing the permit/any unauthorized changes are made to the site/any unauthorized changes are made in the installation of the system. Improvement Permit with plat valid without expiration ☐ Improvement Permit with site plan valid for sixty months ☐ Authorization to Construct is valid for a period equal to that of Improvement Permit – not to exceed sixty months.

Signed: Ginger Cecil Bass date ____
Improvement Permit by: James Shannon date 7-20-06
Authorization to Construct by: James Shannon date 7-20-06

Installed by: ____
Operation Permit by: James Shannon date 8/30/06
Existing System Inspection by: ____ date ____

HEALTH DEPT. COPY: WHITE OWNER COPY (FINAL): YELLOW OWNER COPY (INITIAL): PINK