CHC $125.00 Paid

# IREDELL COUNTY HEALTH DEPARTMENT

STATESVILLE 704-878-5305 MOORESVILLE 704-664-5281

## IMPROVEMENT PERMIT / AUTHORIZATION TO CONSTRUCT / OPERATION PERMIT / EXISTING SYSTEM INSPECTION

PERMIT# CB7944 PIN# 4757352459 DATE Jan 29, 02

OWNER OR CONTRACTOR Dixieland Inc PHONE: Business Home

ADDRESS 4474 Lake Dr. Sherrills Ford NC 28673

LOCATION 21 N. TR Bethany Rd. TR Gilead TR Berea TR Apt 2 ied on left next apt emp

SUBDIVISION Bethany Trace BLOCK / SECTION 2 LOT 53 LOT AREA .687 Ac SITE CLASS RS DESIGN FLOW 360 gpd L.T.A.R.

Septic Tank: 1000 Gallons: STB 825 Date 8-16-02
Pump Tank: 1000 Gallons: PT 362 Date 8-16-02
Pump Make: Zoeller Model N-137-C Serial No 137-0002
Nitrification Field: No Fields 1 Square Feet 900 Linear Feet 300
No Lines 5@60' Trench Width 36" Trench Bottom Depth 36"

☑ New System ☐ Repair System Type: I II III IV V VI
System Description: PM-Innovative -25% Red.
Repair System Description: PM/LP PPBPS
Maintenance Agreement Required: ☐ Yes ☑ No Initially
Gravel Depth N/R ☐ Slab ☑ Crawl Space ☐ Basement w/plumbing ☐ Basement wo/plumbing

☑ House/Mod Home No. Bedrooms 3
☐ Mobile Home No. Bathrooms 2
☐ Business No. Employees
☐ Other


Water Supply: ☐ Individual ☑ Public ☐ Community

Comments/Conditions: Install Laterals at 36" trench bottom depth.


Comments/Conditions: Applicant to RENEW / KEPT ORIGINAL PERMIT, LC 8-7-02

MAINTAIN SETBACKS, ESPECIALLY DRIVEWAY + HEO LINE

1"=50' INITIAL SITE SKETCH

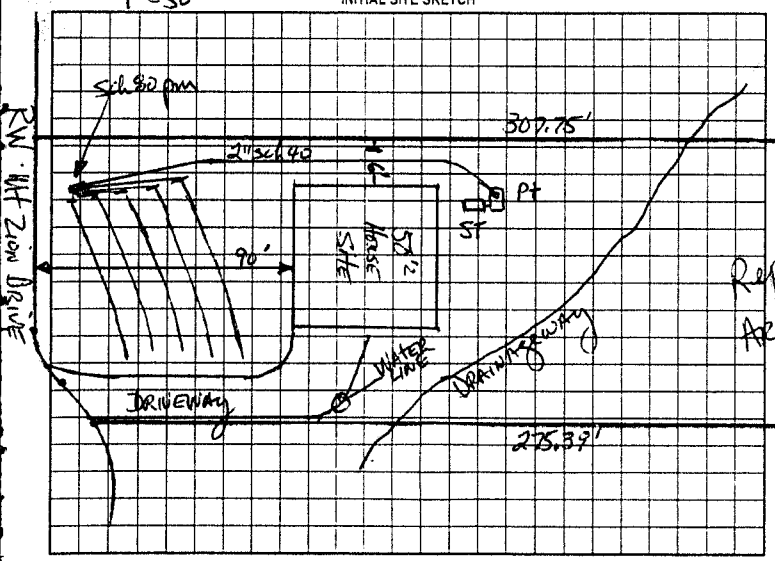


AS BUILT SKETCH

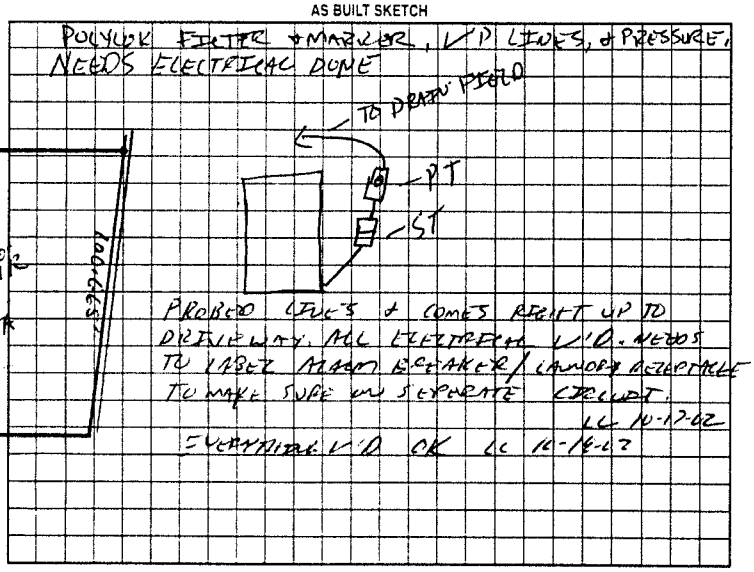


PROBED LINES & COMES RIGHT UP TO DRIVEWAY. ALL ELECTRICAL V/D. NEEDS TO LABEL MAIN BREAKER / CANNOT ACCEPTABLE TO MAKE SURE ON SEPARATE CIRCUIT. LC 10-17-02

EVERYTHING V/D OK LC 10-18-02

Permit can be suspended or revoked if any false information is supplied toward securing the permit/any unauthorized changes are made to the site any unauthorized changes are made in the installation of the system. Improvement Permit with plat valid without expiration. Improvement Permit with site plan valid for sixty months. Authorization to Construct is valid for a period equal to that of Improvement Permit – not to exceed sixty months.

Signed: [signature] date 1/30/02 Installed by ROWAN SEPTIC

Improvement Permit by: [signature] date 1-29-02 Operation Permit by: [signature] date 10/18/02

Authorization to Construct by: STEVE HEDRICK date 7-9-02 Existing System Inspection by: date

HEALTH DEPT COPY: WHITE OWNER COPY (FINAL): YELLOW OWNER COPY (INITIAL): PINK