IREDELL COUNTY HEALTH DEPARTMENT

STATESVILLE 704-878-5305 MOORESVILLE 704-664-5281

IMPROVEMENT PERMIT / AUTHORIZATION TO CONSTRUCT / OPERATION PERMIT / EXISTING SYSTEM INSPECTION

PERMIT# 75151 PIN# 4757352459 PT DATE 8-29-98

OWNER OR CONTRACTOR Dixieland PHONE: Business 828 478 5331 Home

ADDRESS 4474 Lake Dr. Sherrills Ford N.C.

LOCATION US 21 N TL Bethany Rd TR Gilead 4th lot Rt.

SUBDIVISION Bethany Trace BLOCK / SECTION LOT 23 LOT AREA 1.45 acres SITE CLASS PS DESIGN FLOW 360 L.T.A.R. .3

Septic Tank: 1000 Gallons; STB 825 Date 2-6-00
Pump Tank: Gallons; PT Date
Pump Make: Model Serial No.
Nitrification Field: No Fields 1 Square Feet 1200 Linear Feet 400
No Lines 7 Trench Width 36" Max Trench Bottom Depth 36" Gravel Depth 12"

☑ New System ☐ Repair System Type: I, II, III, IV, V, VI
System Description: Conv. Gravity
Repair System Description: 2590 Rct Gravity
Maintenance Agreement Required: ☐ Yes ☐ No
☐ Slab ☐ Crawl Space ☐ Basement w/plumbing ☐ Basement wo/plumbing


☐ House/Mod. Home No. Bedrooms 3
☑ Mobile Home No. Bathrooms 2
☐ Business No. Employees
☐ Other

Water Supply: ☐ Individual ☑ Public ☐ Community

Comments:/Conditions:


Comments:/Conditions:
See Attached Sheet for as built

INITIAL SITE SKETCH

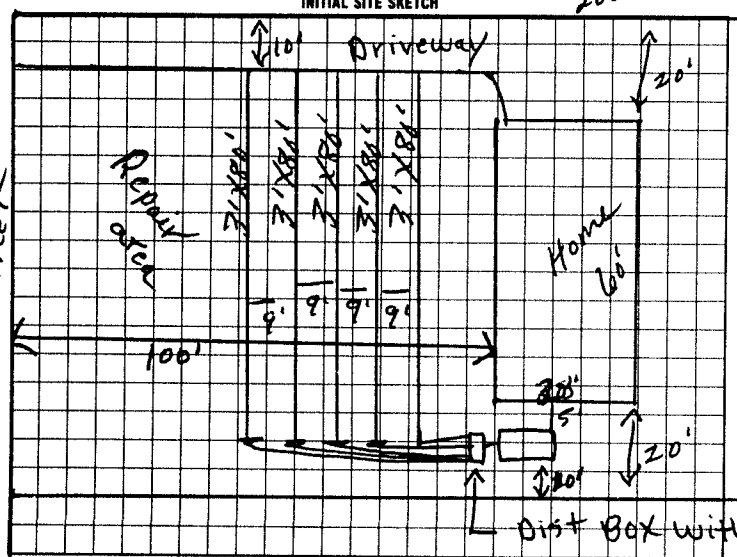

AS BUILT SKETCH

Sketch

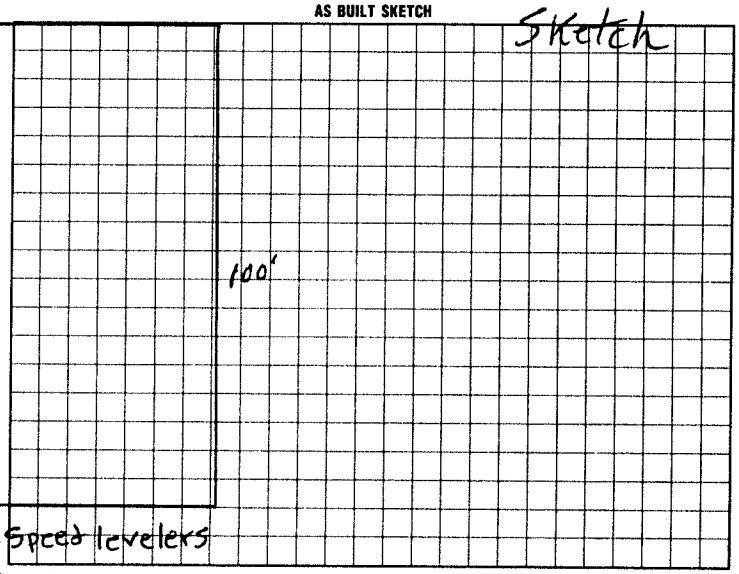

I understand that this permit can be suspended or revoked if any false information is supplied toward securing the permit/any unauthorized changes are made to the site/any unauthorized changes are made in the installation of the system. Improvement Permit with plat valid without expiration. Improvement Permit with site plan valid for sixty months. Authorization to Construct is valid for a period equal to that of Improvement Permit – not to exceed sixty months.

Signed: Regina C Crenshaw date 9/7/98 Installed by: Rowan S.T.

Improvement Permit by: J.C. Moore date 8-29-98 Operation Permit by: J.C. Moore date 4-6-00

Authorization to Construct by: J.C. Moore date 8-29-98 Existing System Inspection by: date

HEALTH DEPT. COPY: WHITE INSPECTION COPY (FINAL): GREEN OWNER COPY (FINAL) YELLOW INSPECTION COPY (INITIAL) PINK OWNER COPY (INITIAL) GOLD